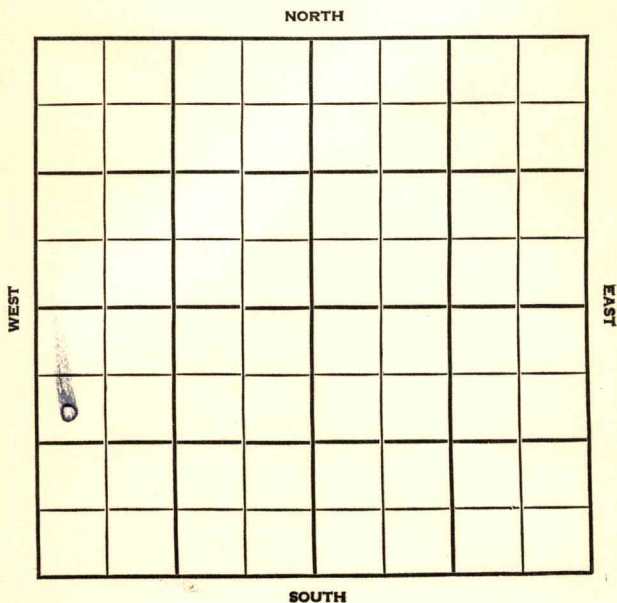


Section 9 Township 32 Range 12 WWell No. #1 OrrCompany Pickrell Drlg. Co.

Barber

KANSAS

SEC.	TWP.	R.
9	32	12W

WELL NO.

#1 Drr

FARM

COMPANY

Pickrell Drlg Co.

CONTRACTOR


WC

Ft. from N. Line

Ft. from S. Line

Ft. from E. Line

Ft. from W. Line

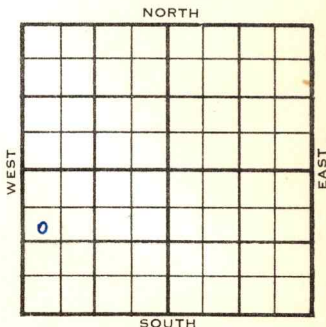

SW NW SW
Magnolia AC

	ELEVATION	REPORT
1955	1516	
9/28	Loc	
10/19	Comm 9-28-55	
	8 5/8" @ 160/150	
	H	3561 3561
	Sd	3683
	L	3739
	M	4277
	TD	4389 4389
	DST 3684-93 open 1 hr	rec 120' sw
	1280/60" DST 4281-4305	open 1 hr
	rec 30' mud	0#
	D & A	

ABANDONED

County **Barber**

Elev.

Sec. **9**Twp. **32**Rge. **12W**Company **Pickrell Drlg. Co.**Farm Name **Orr**No. **1**

TOPS

DEPTH

LOG

DATUM

Loc. in Sec.

Anh.

Tp.

H.

Tr.

Dg.

Bl.

L.

K.C.

B.K.C.

Ce.

C.

M.

M.

K.

Mz.

Mq.

V.

S.

S.

A.

R.

P.F.

G.

T.D.

SW NW SW~~**DS-N/2 SW/4**~~

Geol.

Contr.

Pool

W.C.**FIRST REPORT****0****SEP 28 1955**

Date Comm.

Loc. **Magnolia (AG)****206**

County Barber Elev. 1516
 Sec. 9 Twp. 32 Rge. 12W
 Company Pickrell Drlg.
 Farm Name Orr No. 1

TOPS	DEPTH	LOG	DATUM
Anh.			
Tp.			
H.	<u>3561</u>	<u>3561</u>	<u>2045</u>
Tr.			
Dg. <u>sd.</u>	<u>3683</u>		<u>2167</u>
Bl.			
L.		<u>3739</u>	<u>2223</u>
K.C.			
B.K.C.			
Ce.			
C.			
M.		<u>4277</u>	<u>2761</u>
M.			
K.			
Mz.			
Mq.			
V.			
S.			
S.			
A			
R.			
Pe.			
G.			
T.D.	<u>4389</u>	<u>4389</u>	

Loc. in Sec. _____

SW NW SW

Geol. _____

Contr. _____

Pool _____

Wildcat

Date Comm. 9-28-55 OCT 19 19558 5/8" @ 160/150 DST 3684-93open 1 hr. rec. 120' sw 1280/60"DST 1281-1305 open 1 hr. rec. 30' mud
off

D & A