


Section 10 Township 32 Range 12 W

Well No. # 2 Susie Smith

Company Musgrove Pet.

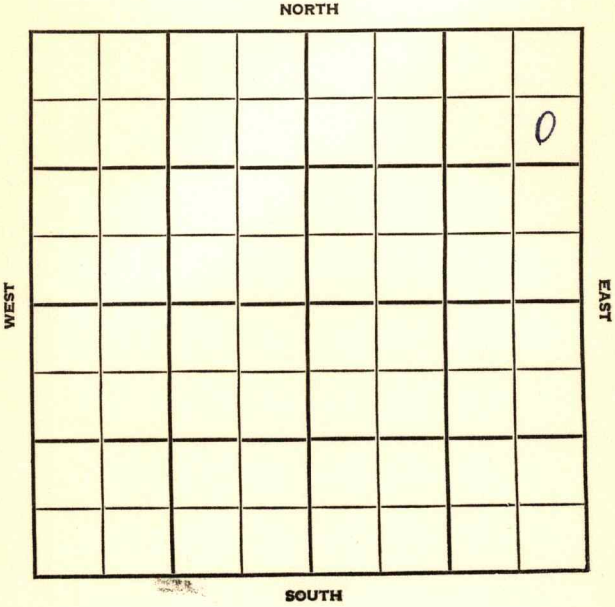

Barber

KANSAS

SEC.	TWP.	R.
10	32	12W

WELL NO.

#2 Susie Smith

FARM

COMPANY

Musgrove Pet.

CONTRACTOR

Co. Tools.

SW Whelan Pool NORTH

990 Ft. from N. Line

Ft. from S. Line

330 Ft. from E. Line

Ft. from W. Line

WEST

EAST

SOUTH

SE NE NE

	ELEVATION	REPORT
1955	1465'	

1/5 Spud 1-2-55
8" @ 171'
WOC

1/19 Spud 1-2-55 D & A TD 4324
8" @ 171' Miss 4240
DST 4240-47 open 2 hr, gas in 1 hr, 30
min, rec 30' GCM 830#
DST 4243-58, open 1 hr rec 840' gas,
10' SOCM, 50' WCM 165#
DST 4258-98 open 2 hr, rec 720' gas
50' SO & GCM, 60' SO & GCM 190#
Miss 4320
DST 4298-4324 open 1 hr rec 31' SOCM
O# TD 4324' D & A

ABANDONED

County Barber State KansasSec. 10 (Blk. Twp.) 32 (Sur. Rge.) 12W Map No.Operator Musgrove Pet.Well No. 2 Farm Susie SmithElev. 1465 Location SE NE NE

					0

990 Ft. From N Line NE330 Ft. From E Line Quarter

1st. Report

Completion JAN 1 9 1955Remarks SW Whelan Pool

Co. tools

Spudding Date 1-2-55Drlg. Data D & A TD 43248" @ 171 Miss. 4240 DST 4240-47open 2 hr. gas in 1 hr. 30 min. Rec.30' gcm 830# DST 4243-58 open 1 hr.Rec. 840' gas 10' socm 50' wcm 165#DST 4258-98 open 2 hr. Rec. 720' gas50' so & gcm 60' so & gcw 190#Miss. 4320 DST 4298-4324 open 1 hr.Rec. 31' socm 0# TD 4324D & A

FABEN GILSTRAP