

KANSAS

Well No. #1 White

Company Musgrove Petroleum

NORTH

WEST

EAST

SOUTH

SEC.	TWP.	R.
11	32	12W

WELL NO.

1 White

FARM

COMPANY

Musgrove Petr.

CONTRACTOR

Musgrove

SW Whelan Pool

Ft. from N. Line

990


Ft. from S. Line

Ft. from E. Line

330

Ft. from W. Line

NW SW NW

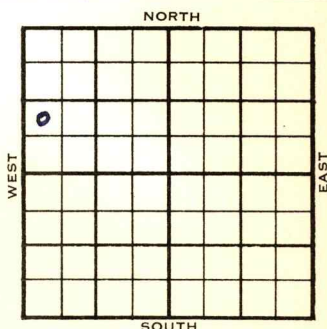

1954

ELEVATION

1464'

REPORT

12/1

Spud 11-28-54

8" @ 188'

Drlg. 1565'

1955

1/12

Spud 11-28-54 Oil well TD 4240'

8" @ 188 DST 3398-3423 open 1 hr.

rec 485' SW 1070# Heeb 3504'

Doug 3653' DST 3651-60 open 1 hr.

rec 145' SW 1380# Lans 3685'

Miss. 4231' DST 4213-39 open 2 hr.

gas in 3 min, rec 150' fluid, 42'

VHOCM, 60' MO, 60' free oil, 1074#

TD 4240' 5" @ 4234 CO B/16 BOPH

5 hr. 250 M-A Petro-frac.

S/5 BOPH 10 hr. Comp. 229 BOPD

COMPLETED

Barber

Kansas

11

(Blk.)
(Twp.)

32

(Sur.)
(Rge.)

12W

Map No.

Musgrove Petroleum

Well No.

1

Farm

White

Elev.

Location

NW SW NW

FIRST REPORT

990

Ft. From

S

Line

NW

330

Fr	From
----	------

W

Line

Quarter

1st. Report

DEC

1

1 1954

Completion

Remarks

FIRST REPORT

Musgrove - Contr.

Spudding Date

11-28-54

Drlq. Data


SW Whelan Pool

8th @ 188

drlg. 1565

FABEN GILSTRAP

County Barber State Kansas
 Sec. 11 (Blk.) 32 (Sur.) 12W Map No.
 Operator Musgrove Petroleum
 Well No. 1 Farm White
 Elev. 1464 Location NW SW NW

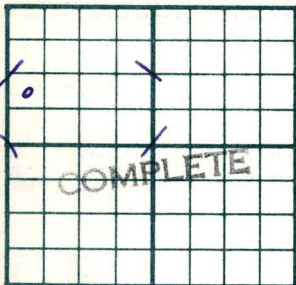

990 Ft. From S Line NW
330 Ft. From W Line Quarter

1st. Report

Completion JAN 12 1955

Remarks SW Whelan Pool

Musgrove - Contr.

Spudding Date 11-28-54

Drlg. Data Oil well TD 4240

8" @ 188 DST 3398-3423 open 1 hr.

Rec. 485' sw 1070# Heeb. 3504

Doug. 3653 DST 3651-60 open 1 hr.

Rec. 145' sw 1380# Lans. 3685

Miss. 4231 DST 4213-39 open 2 hr.

gas in 3 min. Rec. 150' fluid 42' vho cm

60' mo 60' free oil 1074# TD 4240

5" @ 4234 CO B/ 16 boph 5 hr.

250 M-A petro-frac S/ 5 boph 10 hr.

Comp. 229 bopd

FABEN GILSTRAP