


DX 78-1

Section 15 Township 32 Range 12W

Well No. #1 Gillispie

Company Musgrove Petroleum

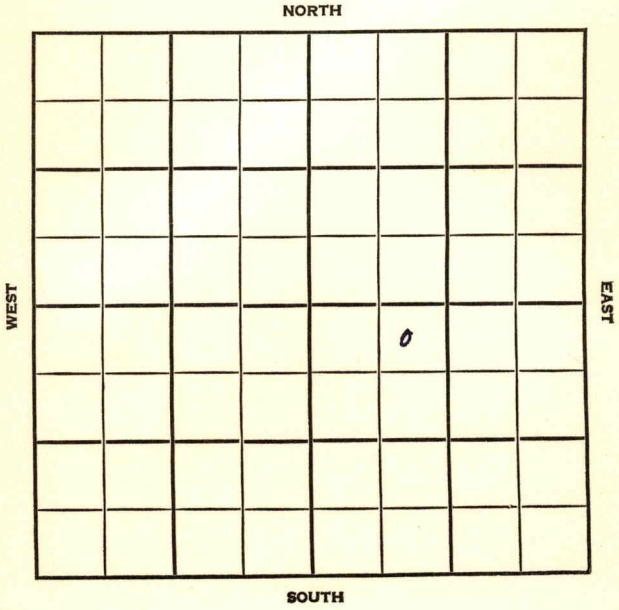

Barber

KANSAS

SEC. 15 TWP. 32 R. 12W

WELL NO. #1 Gillispie FARM

COMPANY Musgrove Petroleum

CONTRACTOR Co. Tools.

Wildcat.

330 Ft. from N. Line

Ft. from S. Line

Ft. from E. Line

990 Ft. from W. Line

NE NW SE

1954 ELEVATION 1558' REPORT

10/20 Spud 10-14-54
8" @ 279'
Drlg. 824'

11/3 Spud 10-14-54 - D&A
TD 4430'
8" @ 279'
Elgin 3442' & Elgin sd 3523'
DST 3510-40', opn 1 hr., rec. 2' mud,
33#
Doug. 3764'
DST 3755-80', opn 1 hr., rec. 1020'
wtr, 1330#
Lans 3794', Miss 4350'
DST 4348-57', opn 1 hr., rec. 9' SO
speck mud, 34#
DST 4350-69, opn 1 hr., rec. 25' socm,
33#
DST 4350-85', opn 1 1/2 hrs., rec. 35'
mud, 0#
TD 4430'
DST 4384-4417', opn 1 1/2 hrs., rec. 17'
so speck mud, 0#
D&A

ABANDONED

County **Barber** State **Kansas**

Sec. **15** (Blk. Twp.) **32** (Sur. Rge.) **12W** Map No.

Operator **Musgrove Petroleum**

Well No. **1** Farm **Gillispie**

Elev. Location **NE NW SE**

330 Ft. From **N** Line **SE**

990 Ft. From **W** Line Quarter

1st. Report **OCT 20 1954**

Completion

Remarks

Co. tools

Spudding Date **10-14-54**

Drlg. Data **Wildcat**

8" @ 279 drlg. 824

FABEN GILSTRAP

