


Section 11 Township 32 Range 12W

Well No. 1 Adams

Company Harms, Burt, Manhart et al

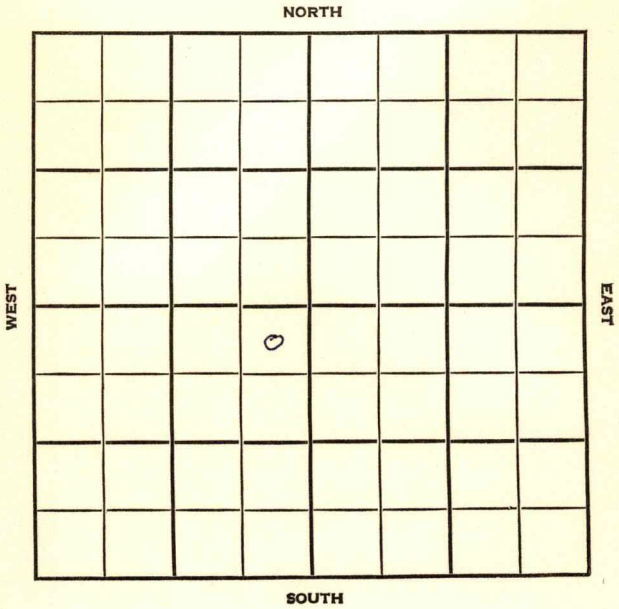

SEC.	TWP.	R.
11	32	12 W

WELL NO. # 1 Adams FARM

COMPANY Harms, Burt, Manhart et al

CONTRACTOR Harms-Burt


SW Wheelan Pool
330 Ft. from N. Line

Ft. from S. Line

330 Ft. from E. Line

Ft. from W. Line

NE NE SW

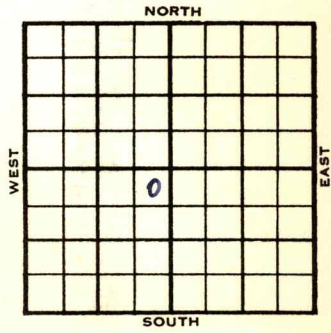

	ELEVATION	REPORT
--	-----------	--------

1955 1457'

3/30 Spud 3-25-55
8" @ 205
Drilg. 2155'

4/13 Spud 3-25-55 D & A TD 4329
8" @ 205 Elgin 3360 Heeb 3480
Doug 3623 Lans 3684
DST 3622-34 open 1 hr rec 180' MO
1260# Miss 4235
DST 4234-43, open 2 hr rec 20' mud,
350#
DST 4243-49 open 2 hr gas in 1 1/2 hr.
rec 60' VSOCM, 60' OCM, 640#
DST 4249-60 open 2 hr, rec 12' VSOCM,
12' WM, 160# TD 4329' D & A

ABANDONED

