


Section 14 Township 32 Range 12W

Well No. #1 Cottrell-Smith

Company E.H. Adair

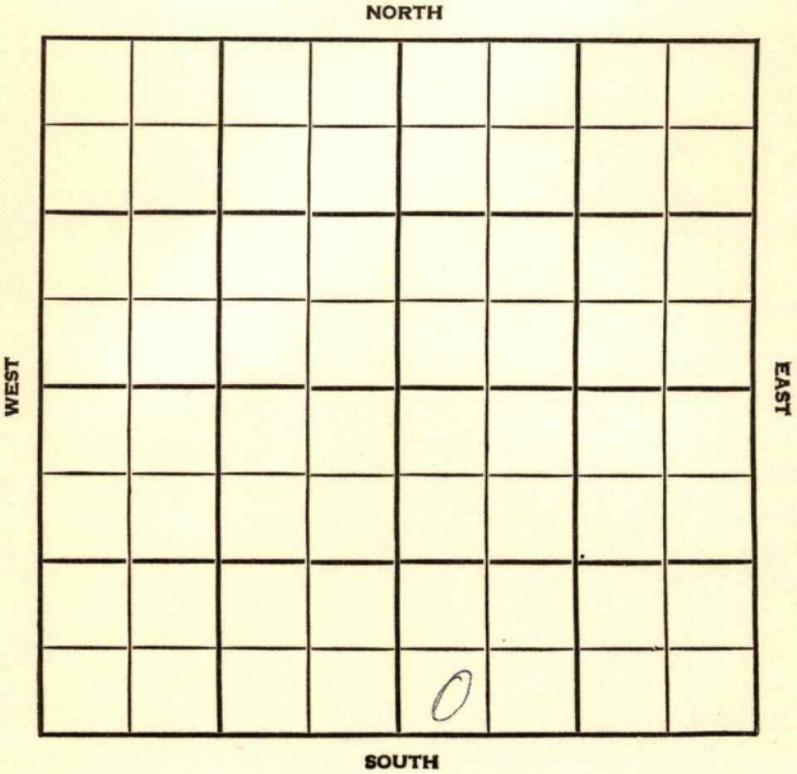

County Barber Elev. _____
 Sec. 14 Twp. 32 Rgs. 12W
 Company E. H. Adair
 Farm Name Cottrell-Smith No. 1

TOPS	DEPTH	LOG	DATUM
Anh.			
Tp.			
H.			
Tr.			
Dg.			
Bl.			
L.			
K.C.			
B.K.C.			
Ce.			
C.			
M.			
M.			
K.			
Mz.			
Me.			
V.			
S.			
S.			
A.			
R.			
Pe.			
G.			
T.D.			

Loc. in Sec.

SW SW SE


Geol.

Contr.

Co. Tools

Pool

Bloom

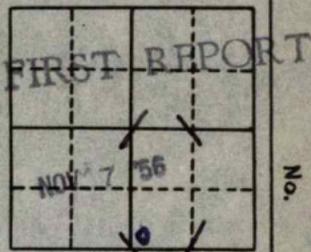

Date Comm. spd. 11-4-56 Skelly (FO)
8" @ 200, w/165, Drlg. 290

NOV 5 1956

R. G.

Co.

Lse.

No.

Sec.

T.

R.

County Barber Elev. 1509
 Sec. 14 Twp. 32 Rge. 12W
 Company E. H. Adair
 Farm Name Cottrell-Smith No. 1

	TOPS	DEPTH	LOG	DATUM	Loc. in Sec.
Anh.	<u>519</u>	<u>3372</u>			SW SW SE
Tr.					
H.		<u>3545</u>			
Dg.		<u>3561</u>			
Bl.		<u>3740</u>			
L.		<u>3747</u>			
K.C.					Geol.
B.K.C.					Contr.
Ce.					Co. Tools
C.					Pool
M.		<u>4310</u>	<u>4307</u>		Bloom
M.					
K.			<u>4486</u>		
M.	<u>chata</u>		<u>4566</u>		
Me.					
V.			<u>4602</u>		
S.			<u>4676</u>		
S.					
A.					
R.					
Pe.					
G.					
T.D.		<u>4682</u>			



Date Comm. spd. 11-4-56 Skelly (FO)

8" @ 200, w/165, Drlg. 290 NOV 13 '56

Ø 3798 NOV 21 '56 DST 4104-12
1hr 150' GCMW BHP 960/20
DST 4309-30 90" rec 180' VSOCWM
BHP 240/20 DST 4330-52 90"
rec 2700' SW NOV 28 '56 DST 4672-82
90" 720' GIP rec 150' 50' GCMW
+450' w/165 FK 145-285 BHP 1175/20"
D & A