


Barber

KANSAS

SECTION 17 TOWNSHIP 32S RANGE 12W

WELL NO. #1 Forsyth "B"

COMPANY Pickrell Drlg. + Mfg.

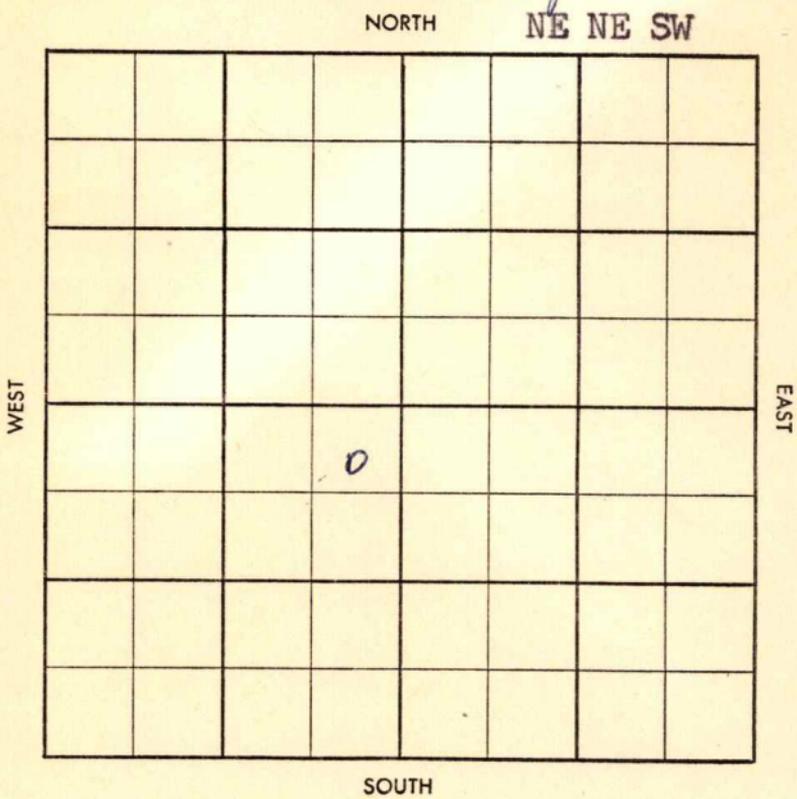

Twp. ~~X~~ Pool ~~X~~  
 Co. ~~X~~ Facet ~~26~~

S-513-B

County Barber Elev. \_\_\_\_\_  
 Sec. 17 Twp. 32 Rge. 12W  
 Company Pickrell Drlg.  
 Farm Name Forsyth "B" No. 1

TOPS	DEPTH	LOG	DATUM
Anh.			
Tp.			
H.			
Tr.			
Dg.			
B.L.			
L.			
K.C.			
B.K.C.			
Ce.			
C.			
M.			
M.			
K.			
Mz.			
Mq.			
V.			
S.			
S.			
A.			
R.			
Pf.			
G.			
T.D.			

Loc. in Sec. NE NE SW  
 Geol. \_\_\_\_\_  
 Contr. \_\_\_\_\_  
 Pool Forsyth



Date Comm. 4450' test

Location  
 \_\_\_\_\_  
 \_\_\_\_\_  
 \_\_\_\_\_  
 \_\_\_\_\_  
 \_\_\_\_\_

Co.  
 Lse.  
 No.  
 Sec.  
 T.  
 R.

**CORRECTION**

Twp.  Pool   
 Co.  Foot.

9-513-B

County Barber Elev. 1571 OF 1574 RB  
 Sec. 17 Twp. 32 Rge. 12W  
 Company Pickrell Drig. & Mag  
 Farm Name Forsyth "B" No. 1

TOPS	DEPTH	LOG	DATUM
Anh.			
Tp.			
H.	3619		
Tr.			
Dg.	3700		
B.L.			
L.	3801		
K.C.			
B.K.C.			
Ce.			
C.			
M.	4322		
M.			
K.			
Mz.			
Mq.			
V.			
S.			
S.			
A.			
R.			
Pf.			
G.			
T.D.	4418		

Loc. in Sec. NE NE SW

Geol.       
 Contr.     

Pool Forsyth

**COMPLETE**  
 SEP 10 '58

Date Comm. 6-2-58 4450' test  
 Location JUN 3 '58 9"200 MIRT JUN 11 '58

Ø 3880 JUN 18 '58 DST 4318-40  
60" 9/3" ga 867 muf 15" ga 1.780 muf  
145" rec 270' Hgem FP 245-340  
BHP 1550-1525 120" DST 4340-70  
17" 9/2" ga 1.790 muf 13" ga 2.  
930 muf 10" spray oil 15" rec  
120' ga FP 645-850 BHP 1555  
- 5 1/2" 4417/100 wocd JUN 25 '58

JUL 2 '58

JUL 9 '58 CO 2383 80/4346-66  
 Tbg Flo 230 ph NW 27/64"  
 Tbg chk 2.680 mcf FTP  
 600 FCP 810 sd frac 7.5 x 7.5  
 Field rec'd Flo 230 ph NW  
 hrs 2.740 MCF 1/4" chk  
 FTP 1165 FCP 1305 SICP 1400  
 SITP 1395 w opat JUL 16 '58 JUL 23 '58  
 JUL 30 '58 AUG 6 '58 AUG 13 '58 CSO ca op Flo  
 9.511 MCF AUG 20 '58 AUG 27 '58  
~~AUG 27 '58~~ SEP 3 '58 X CSO ca op Flo  
 9.511 MCF SEP 10 '58

ca op Flo 9.511 MCF  
 + 230 ph  
