


Section 19 Township 32 Range 12W

Well No. #3 Warren Fee

Company Skelly Oil

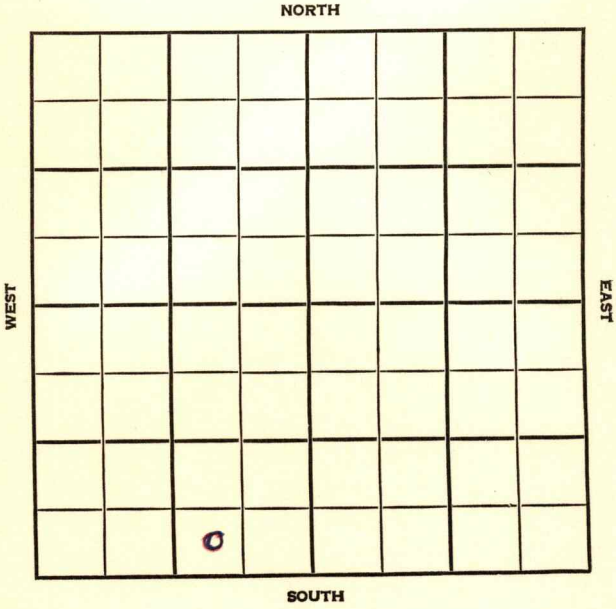

Barber

KANSAS

SEC.	TWP.	R.
19	32	12W

WELL NO.

3 Warren Fee

FARM

COMPANY

Skelly Oil

CONTRACTOR

Ft. from N. Line

330'


Ft. from S. Line

990'

Ft. from E. Line

Ft. from W. Line

SW SE SW

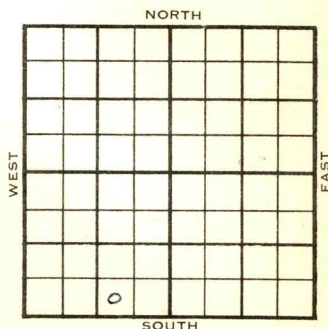

1955

ELEVATION

REPORT

6/1

Location

7/7

5-29-55, 8 58" @ 319/175 DST 4389-4436
 open 1 hr. Gas in 3 min. 1500 mcfg
 Ref. 50' som 120' o & gcm 120' gcmo
 1590/20" DS 4436-77 open 2 hr. Rec 55'
 mud 80# 5 1/2" @ 4477/200 CO to 4470 198/
 4407-40 396 mcfg 500A frac F/153 bo 3bw
 24 hr. Comp/F/275 bopd.

Tops:	Depth	Datum
H.	3694	2079
L.	3880	2265
BKC	4305	2690
Ce. arm	4314	2699
M.	4396	2781
TD.	4477	

COMPLETED

County Barber Elev. 1615
 Sec. 19 Twp. 32 Rge. 12W
 Company Skelly Oil
 Farm Name Warren Fee No. 3

TOPS	DEPTH	LOG	DATUM	Loc. in Sec.
Anh.				SW SE SW
TP.				
H.	<u>3694</u>		<u>2079</u>	
Tr.				
Dg.				
BL.				
L.	<u>3880</u>		<u>2265</u>	Geol.
K.C.				
B.K.C.	<u>4305</u>		<u>2690</u>	Contr.
Ce. <u>norm</u>	<u>4314</u>		<u>2699</u>	
C.				
M.	<u>4396</u>		<u>2781</u>	Pool
M.				
K.				
Mz.				
Mq.				
V.				
S.				
S.				
A.				
R.				
PE.				
G.				
T.D.	<u>4477</u>			

COMPLETE

0

Date Comm. 5-29-55 JUL 6 1955

8 5/8" @ 319/175 DST 4389-4436

open 1 hr. Gas in 3 min. 1500 mcf/g

Rec. 50' socm 120' o & gcm 120' gcmO

1590/20" DST 4436-77 open 2 hr.

Rec. 55' mud 80# 5 1/2" @ 4477/200

CO to 4470 198/ 4407-40 396 mcf/g

500 A frac F/ 153 bo 3 bw 24 hr.

Comp/ F/ 275 bopd