

Section 25 Township 32 Range 13 WWell No. # 1 LonkerCompany Anschutz Drilling Co.

NORTH

							0

WEST

EAST

SOUTH

Barber KANSAS

SEC. 25	TWP. 3 2	R. 13W
WELL NO. 1 Lonker		
COMPANY Anschutz Drlg. Co.		FARM
CONTRACTOR		


Wildcat

330 _____ Ft. from N. Line

_____ Ft. from S. Line

330 _____ Ft. from E. Line

_____ Ft. from W. Line

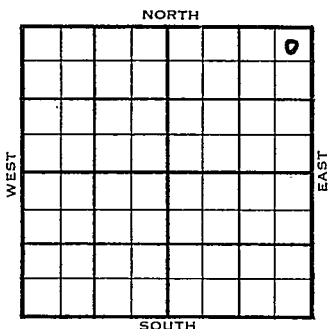

NE NE NE

Skelly Oil DHM - SinclairDHM

	ELEVATION	REPORT
1954	1653'	

9/29 MIRT

12/1 Spud 9-28-54 Oil well TD 4970
 8-5/8" @ 321 Elgin 3621 Heeb 3722
 Doug 3794
 DST 3790-3888 open 1 hr rec 7' mud
 220# Lans 3896 Miss 4457
 DST 4458-64 open 1 hr rec 20' mud
 104#
 DST 4465-93 open 2 hr, rec 10' gassy
 mud, 30' SO & GCM, 60' HO & GCM,
 180' muddy GCO, 80' free oil, 40' wtr.
 945# Viola 4745 Arb. 4954'
 TD 4970 5" @ 4556 CO 9/4472-74
 78/4480-93 FU 200' wtr. 100' oil
 Hydro. S/6 BOPH P/38 BO 10 hr.
 Comp. 161 BOPD

COMPLETED

FABEN GILSTRAP

County Barber State Kansas
 Sec. 25 (Blk. 32 (Sur. 13W Map No.)
 (Twp.) (Rge.)

Operator Anschutz Drlg.

Well No. 1 Farm Lonker

Elev. 1653 Location NE NE NE

330 Ft. From N Line NE

330 Ft. From E Line Quarter

1st. Report

Completion DEC 1 1954

Remarks Wildcat

Spudding Date 9-28-54

Drlg. Data Oil well TD 4970

8 5/8" @ 321 Elgin 3621 Heeb. 3722

Doug. 3794 DST 3790-3888 open 1 hr.

Rec. 7' mud 220# Lans. 3896

Miss. 4457 DST 4458-64 open 1 hr.

Rec. 20' mud 104# DST 4465-93

open 2 hr. Rec. 10' gassy mud 30' so &

gem 60' ho & gem 180' muddy geo

80' free oil 40' wtr. 945#

Viola 4745 Arb. 4954 TD 4970

5" @ 4556 CO 9/ 4472-74 78/ 4480-93

FU 200' wtr. 100' oil Hydro.

S/ 6 boph P/ 38 bo 10 hr.

Comp. 161 bopd

FADEN GILSTRAP