

KANSAS


Barber

Form 51—5M—7-39—Palace

Section 26 Township 32 Range 13-W

Well No. #1 Pinning

Company Sinclair Prairie

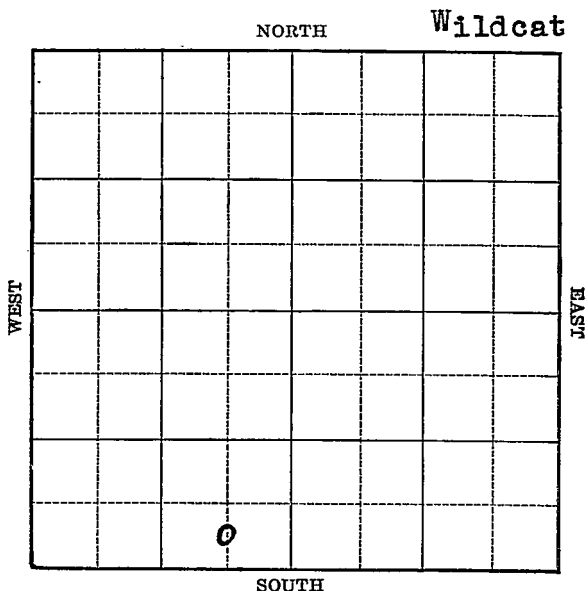

Sec. 26 Twp. 32 R. 13 -W

Well No. #1 Pinning Farm _____

Sinclair-Prairie

Company

(Wildcat)

Ft. from N. Line

330 Ft. from S. Line

660 Ft. from E. Line

Ft. from W. Line

Elev. 1670¹

SOUTH


1940	REPORT
4/24	Location
5/2	RU & SD.
5/9	Surface hole.
5/16	13" - 352' SD.
5/23	" " "
5/29	Drlg. 2265'
6/6	Coring 3800'
6/13	K.C. 3930' Miss. 4430'
	Chat. 4448' Core 4456-66' SSO
	Core 4466-76'
6/20	B. Miss. 4590' Viola 4769'
	Drlg. 4828'
6/27	Simp. sh. 4857' Simp. Dol. 4867'
	Wilcox 4869' S.O. 4876-83'
	S.O. 4483-90' Arb. 4975'
	Coring 5004' No shows.
7/3	Drlg. 5083'
7/11	7" - 5050' WOC.
	OVER

1940:

7/17

Arb. 4975'

7" - 5050'

T.D. 5083'

Water.

ABANDONED


Map No. 93 Sec. 26 Twp. 32 R. 13WWell No. 1 PinningSinclair Prairie Company

Contractor

FIRST REPORT

C S L SE SW

SECTION PLAT

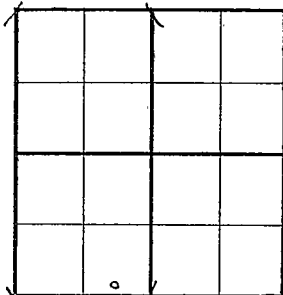 Ft. from N. Line330 Ft. from S. Line660 Ft. from E. Line Ft. from W. Line

WILDCAT

Location XRig up Drilling and Remarks:

RECORD

Cased in., ft.Sand Gas Oil Total Depth

PRODUCTION

1st 24 hrs. Nat. 1st 24 hrs. after shot Gas Cu. Ft.Dry Hole Abandoned

Date

APR 24 1940₁₉S. J. LEWIS Scout

Map No. 93 Sec. 26 Twp. 32 R. 13WWell No. 1 PinningSinclair Prairie Company

Contractor

ABANDONED
C S L SE SW

SECTION PLAT

 Ft. from N. Line330 Ft. from S. Line660 Ft. from E. Line Ft. from W. Line

WIIDCAT

Location Rig up

Drilling and Remarks:

*CEL 4975-**7" @ 5050**Water.*

RECORD

Cased in., ft.Sand Gas Oil Total Depth 5283

PRODUCTION

1st 24 hrs. Nat. 1st 24 hrs. after shot Gas Cu. Ft.Dry Hole Abandoned

Date

JUL 17 1940 19 S. J. LEWIS Scout