


Section 15 Township 32 Range 13W

Well No. #1 Smith "W"

Company Petroleum Inc.

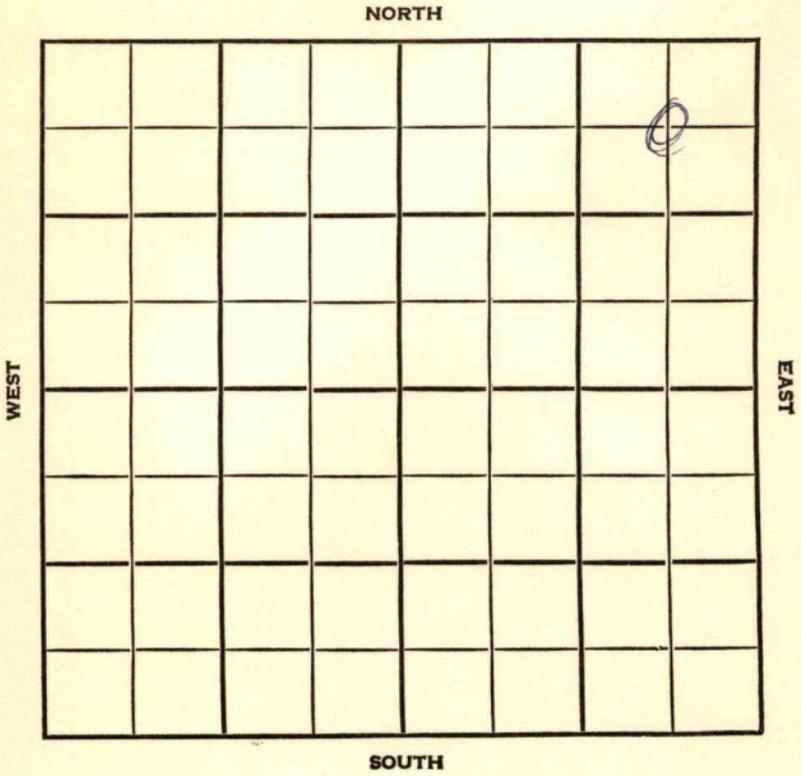

~~Barber~~

Elev. 1749

Co.

~~15~~ ~~Temp.~~ 32

Rge. 13W

Company Petroleum Inc.

Farm Name Smith "W".

No. 1

TOPS	DEPTH	LOG	DATUM
Ahb.			
TP.			
H.	3784		
Tr.			
Dg.	3820		
Bl.			
L.			
K.C.	3963		
B.K.C.	4380		
Ce.			
C.			
M.	4472		
M.			
K.			
Mz.			
Ma.			
V.			
S.			
S.			
A.			
R.			
PE.			
G.			
T.D.	4572		

Loc. in Sec. C NE NE

Geol.

Contr.

Co. Tools

Pool

Brooks-Younger

Use.

NOV 7 '56 0

ABANDONED

1/2 mile

No.

Date Comm. Monsanto Ac. cont.

Location 10-18-56 858

254/165 D 3100 OCT 31 '56

D 4498 NOV 7 '56 DST 4472-4500

1hr G/8" TSTM rec 56' GCM

no BHP record DST 4472-4525

1hr G/8" TSTM rec 56' GCM BHP

0

D&A.

Sec.

T.

R.