
FORM 51

Barber KANSAS

Section 26 Township 32 Range 13 W

Well No. # 1 Lonker "B"

Company Superior Oil

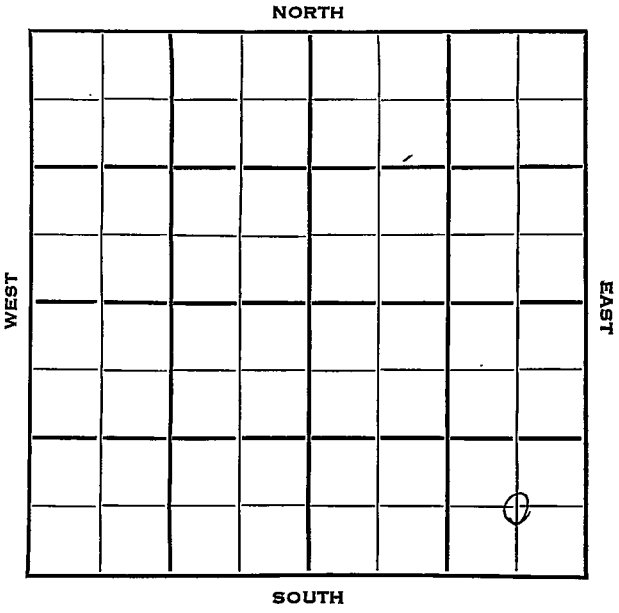

Barber KANSAS

SEC.	TWP.	R.
26	32	13W

WELL NO.

1 Lonker "B" FARM


COMPANY

Superior Oil

CONTRACTOR

Peel

Medicine Lodge Pool

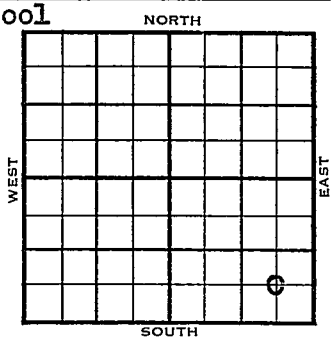

_____ Ft. from N. Line

660 Ft. from S. Line

660 Ft. from E. Line

_____ Ft. from W. Line

C SE SE

1953 ELEVATION 1614' REPORT

12/2 MIR

12/9 10" @ 556'
Anhy 1495'
Drlg. 2205'

12/16 Drlg 3526'

1954
1/13 Spud 12-2-53
Gas Well
TD 3894'
10" @ 556'
Anhy 1525', Elgin 3520', Heeb 3703', Doug 3750'
DST 3766-94', opn 1 hr., rec. 427' sw, 1400#
DST 3832-54', opn 1 hr., rec. 4 3/4 mcfg, 150' sw, 1440#
DST 3826-37', opn 1 hr., rec. 2 mcfg, 1' dist, 1405#
Lans 3884'
TD 3894
7" @ 3894'
CO to 3860
4/3831-32, 48/3831-37, 2,203,000 gas, Tonganoxie sd 3772'
Comp. opn flow 2,116,000 gas, 1360#

COMPLETED

DX-78

FORM 275 FOR SALE BY KANSAS BLUE PRINT CO.


County Barber State Kansas

Sec. 26 (Blk. Twp.) 32 (Sur. Rge.) 13W Map No.

Operator Superior Oil

Well No. 1 Farm Lonker "B"

Elev. Location C SE SE

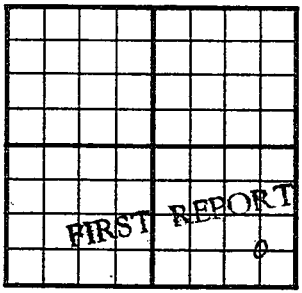

660 Ft. From S Line SE

660 Ft. From E Line Quarter

1st. Report DEC 2 1953

Completion

Remarks

Peel - Contr.

Spudding Date

Drlg. Data Medicine Lodge Pool

M I R

J. G. McGEHEE

FORM 275 FOR SALE BY KANSAS BLUE PRINT CO.


County Barber State Kansas

Sec. 26 (Blk. Twp.) 32 (Sur. Rge.) 13W Map No.

Operator Superior Oil

Well No. 1 Farm Lonker "B"

Elev. 1614 Location C SE SE

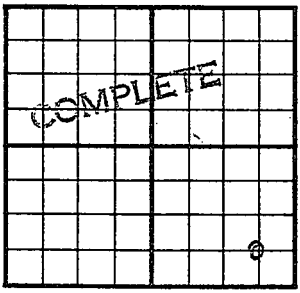

660 Ft. From S Line SE

660 Ft. From E Line Quarter

1st. Report

Completion JAN 13 1954

Remarks Medicine Lodge Pool

Peel - Contr.

Spudding Date 12-2-53

Drlg. Data Gas well TD 3894

10" @ 556 Anhy 1525 Elgin 3520

Heeb. 3703 Doug. 3750 DST 3766-94

open 1 hr. Rec. 427' sw 1400#

DST 3832-54 open 1 hr. Rec. 4 3/4 mcfg

150' sw 1440# DST 3826-37 open 1 hr.

Rec. 2 mcfg 1' dist. 1405# Lans. 3884

TD 3894 7" @ 3894 CO to 3860

4/ 3831-32 48/ 3831-37 2,203,000 gas

Tonganoxie sd. 3772

Comp. open flow 2,116,000 gas 1360#

J. G. McGEHEE