


Barber

KANSAS

SECTION 27 TOWNSHIP 32 RANGE 13W

WELL NO. #1 Kelly

COMPANY Time Petroleum

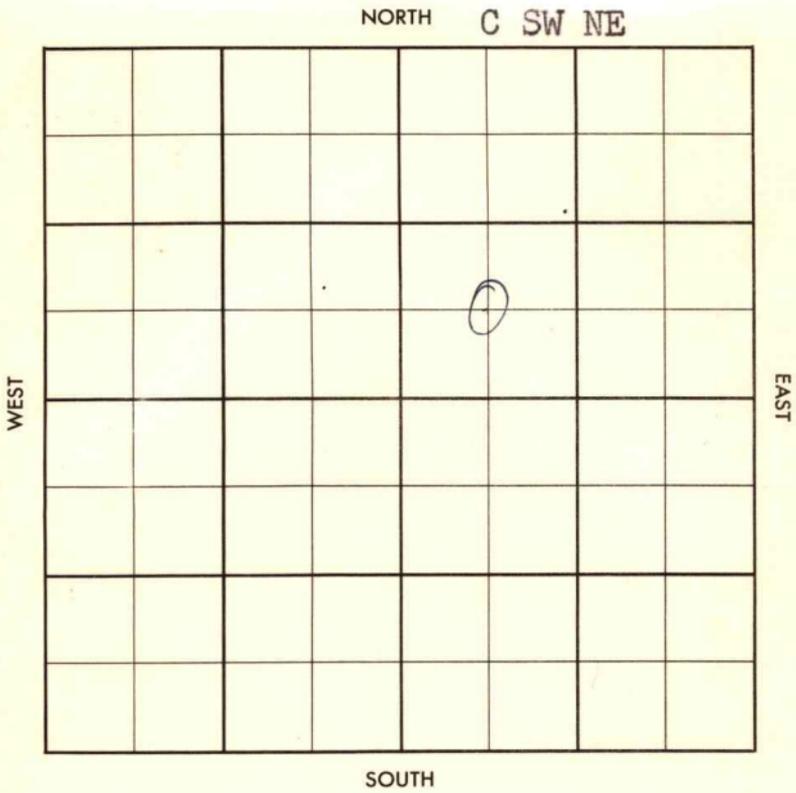

County Barber Elev. 1680
 Sec. 27 Twp. 32 Rgs. 13W
 Company Time Petroleum
 Farm Name Kelly No. 1

TOPS	DEPTH	LOG	DATUM	Loc. in Sec.
Anh				C SW NE
Tp. <u>E192n</u>	<u>3437</u>			
H.				Geol.
Tr.	<u>3759</u>			
Dg.				Contr.
Bl. <u>D9sd</u>	<u>3784</u>			
L.				Kirkpatrick
M.	<u>4430</u>			
K.C.				Pool
B.M.C.				
Ce.				Wildcat
C.				
M.				APR 3 '57
M.				
K.				0
Mz.				
Ma.				ABANDONED
V.				
S.				
S.				
A.				
R.				
Pe.				
G.				
TD.	<u>4540</u>			

Date Comm. Skelly (DHM)

RURT 3-12-57 10 3/4
300 173050 DST 3820-78
2 hrs 750' with BHP 1600
Broke down 4185 APR 3 '57 DST 4438
-65 up 2 hrs 6/85" per 30' Md
BHP 1265/30"

DEA

WILDCAT

FORM 513 SUNRAY

County Barber Elev. _____
 Sec. 27 Twp. 32 Rgs. 13W
 Company Time Petroleum
 Farm Name Kelly No. 1

TOPS	DEPTH	LOG	DATUM	Loc. in Sec.
Anh.				C SW NE
Tp.				
H.				
Tr.				
Dg.				
Bl.				
L.				Geol. _____
K.C.				Contr. _____
B.K.C.				Kirkpatrick
Ce.				
C.				Pool
M.				Wildcat
M.				
K.				FIRST REPORT
Mz.				
Me.				MAR 13 '57
V.				
S.				
S.				
A.				
R.				
PE.				
G.				
T.D.				

Date Comm. Skelly (DHM)
RURT

~~26~~

Co.
No.
Sec.
T.
R.