


Section 35 Township 32 Range 13W

Well No. 1 Mattie Binning

Company Skelly Oil

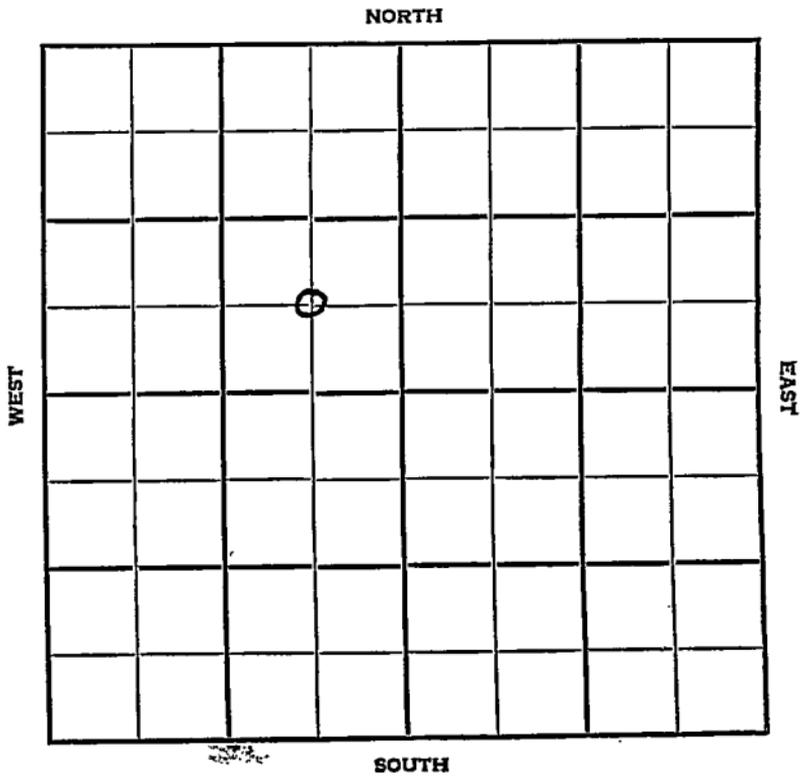

Barber KANSAS

SEC.	35	TWP.	32	R.	✓13W
------	----	------	----	----	------


WELL NO. **1 Mattie Binning** FARM

COMPANY **Skelly Oil**

CONTRACTOR

**Medicine Lodge Pool**

\_\_\_\_\_ Ft. from N. Line  
**660** \_\_\_\_\_ Ft. from S. Line  
**660** \_\_\_\_\_ Ft. from E. Line  
 \_\_\_\_\_ Ft. from W. Line

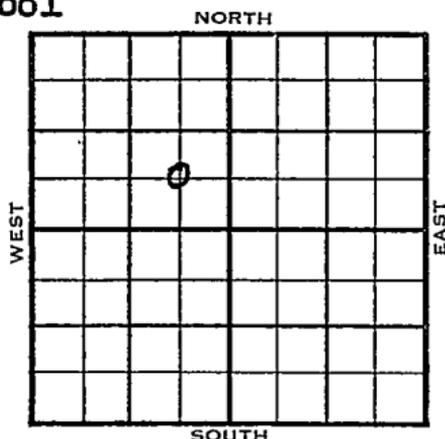

**C SE NW**

<b>1954</b>	ELEVATION <b>1637</b>	REPORT
-------------	--------------------------	--------

**7/28** Spdg 7-24-54  
 8" @ 473

**8-11** Spdg 7-24-54  
 D&A  
 TD 3986  
 8" @ 473  
 Heeb 3680 Tong. 3766  
 DST 3765-90 open 1 hr. Rec. 10' mud  
 1151#  
 DST 3788-3870 open 1 hr. Rec. 8'  
 mud 262#  
 Br. lime 3881 Lans. 3899  
 TD 3986  
 D&A

**ABANDONED**

County Barber State Kansas

Sec. 35 (Blk. 32) (Sur. 13W) (Twp.) (Rge.) Map No.

Operator Skelly Oil

Well No. 1 Farm Mattie Binning

Elev. 1637 Location C SE NW


**ABANDONED**

660 Ft. From S Line NW

660 Ft. From E Line Quarter

1st. Report \_\_\_\_\_

Completion AUG 11 1954

Remarks Medicine Lodge Pool

Spudding Date 7-24-54

Drlg. Data D & A TD 3986

8" @ 473 Heeb. 3680 Tong. 3766

DST 3765-90 open 1 hr. Rec. 10' mud

1151# DST 3788-3870 open 1 hr. Rec.

8' mud 262# Br. lime 3881

Lans. 3899 TD 3986

D & A

72

