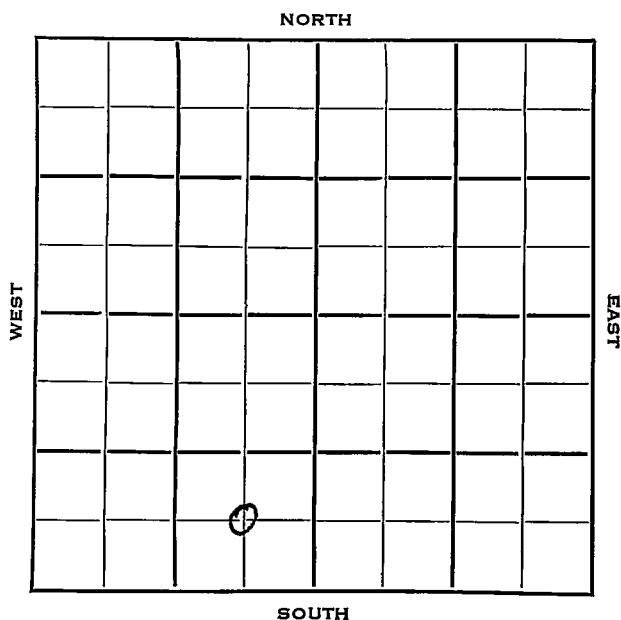


Section 35 Township 32 Range 13WWell No. 2 Lonker "A"Company Skelly Oil

Barber

KANSAS

SEC.	TWP.	R.
35	32	13W ✓

WELL NO.

2 Lonker "A"

FARM

COMPANY

Skelly Oil

CONTRACTOR


Medicine Lodge Pool

_____ Ft. from N. Line

660 _____ Ft. from S. Line

660 _____ Ft. from E. Line

_____ Ft. from W. Line

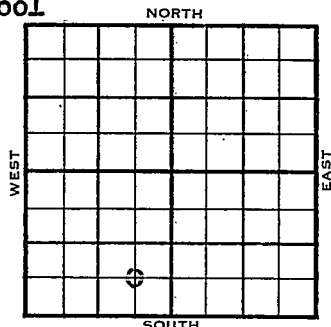

C SE SW

	ELEVATION	REPORT
1953	1644'	
10/28	MIR	
11/4	8" @ 515'	
	Drlg 2405'	
11/11	Heeb 3715', Tong 3798'	
	DST 3793-3817' 50 mins, no fluid.	
	DST 3810'-47' 1 hr, 150,000 gas, 115'	
	SW 1170# Lans 3918'	
	RTD 3945'	
11/18	Schl	
	5" @ 3860'	
	CO 3855'	
12/16	24/ 3832-36	7 gwph 15 hrs. 396,000 gas
	Spud 10-26-53	
	D & A	
	TD 3945'	
	8" @ 515'	
	Heeb 3715', Tonganoxie 3798'	
	DST 3793'-3817' opn 50 min failed.	
	DST 3810'-47' opn 1 hr, rec 150,000	
	gas 115' sw, 1170# Lans 3918'	
	TD 3945'	
	5" @ 3860'	
	CO to 3855'	
	24/ 3832-36	

OVER

1953

Information brought forward.

12/16 7 gwph 15 hr. 396,000 gas sd-oil-
frac 7 gwph 312,000 gas PB 3830'
47/ 3821-29 537,000 cfg 48/ 3813-
21,458,000 gas 9/ 3812-13 560,000
gas sd-oil-frac 54 gw 100,000
cfg 9 hr. 1000 A S/ 8 bwph 7 hr.
sq. perf. CO to 3848'
72/ 3812-29 1000A
S/ 20 bwph 14 hr.
D & A

ABANDONED

County Barber State Kansas

Sec. **35** (Blk. Twp.) **32** (Sur. Rge.) **13W** Map No.

Operator Skelly 0:1

Well No. **2** Farm **Lonker "A"**

[illegible]

FIRST REPORT

660 Ft. From S Line SW

660 Ft. From E Line Quarter

1st. Report OCT 28 1953

Completion

Remarks

Spudding Date

Drlg. Data Medicine Lodge Pool

M I R

J. G. McGEHEE