


Section 36 Township 32 Range 13 W

Well No. # 4 Lonker

Company Skelly Oil

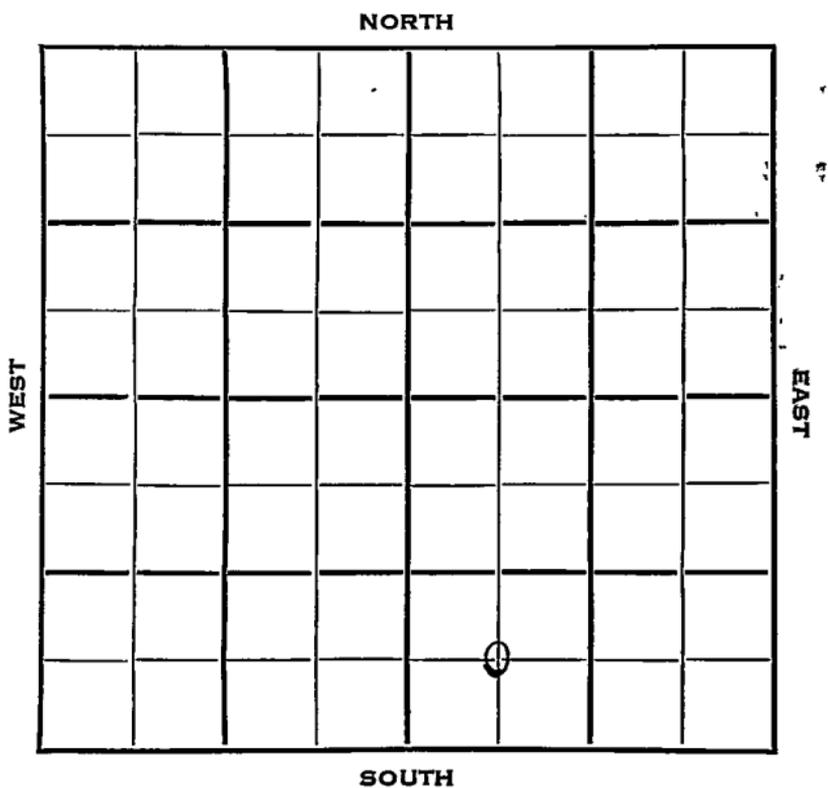

Barber KANSAS

SEC. 36 TWP. 32 R. 13W ✓


WELL NO. 4 Lonker FARM

COMPANY Skelly Oil

CONTRACTOR

Medicine Lodge Pool

_____ Ft. from N. Line
 660 _____ Ft. from S. Line
 _____ Ft. from E. Line
 660 _____ Ft. from W. Line

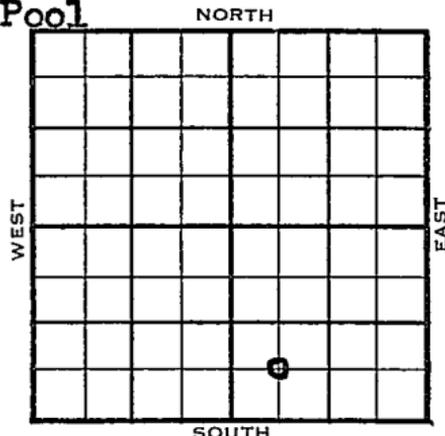

C SW SE

1954 ELEVATION 1696' REPORT

4/21
 5/5

Location
 8" @ 515 w/300 sks
 Elgin Sd 3688', Heeb 3698', Doug 3800'
 DST 3851'-96'

5/26

Spud 4-23-54 D & A TD 4965
 8" @ 515 Elgin sd 3688 Heeb 3698
 Doug 3809
 DST 3851-96 open 20 min, rec 5' mud.
 84# DST 3896-3928 open 1/2 hr rec 510'
 SW 1134# Br. lime 3972 Lans 3982
 Miss 4490
 DST 4490-4530 open 1 hr rec 75' GCM
 1580# Viola 4830 Simp. 4924
 Simp. 4924 Simp. sd. 4944
 DST 4918-65 open 1 hr rec 1530' SW
 D & A

ABANDONED

