


Section 36 Township 32 Range 13 W

Well No. # 2 Lonker "A"

Company Superior Oil

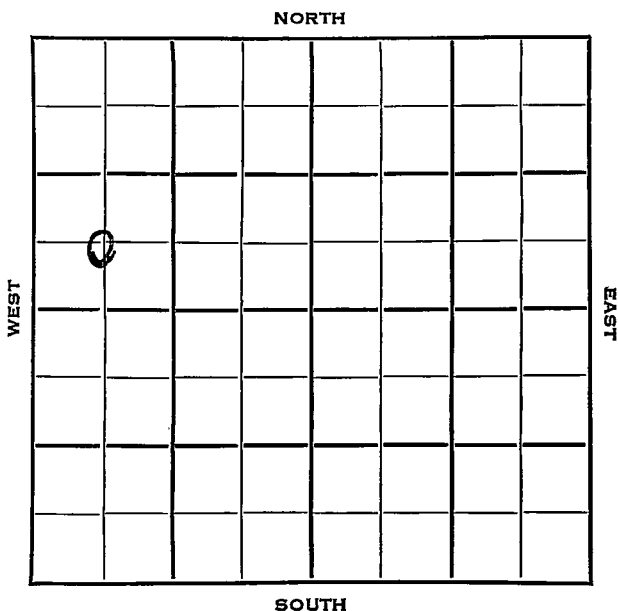

~~BARBER~~
~~Barber~~

KANSAS

SEC.	TWP.	R.
36	32	13W

WELL NO.

2 Lonker "A"

FARM

COMPANY

Superior Oil

CONTRACTOR

Peel

Medicine Lodge Pool

NORTH

Ft. from N. Line


660

Ft. from S. Line

Ft. from E. Line

650

Ft. from W. Line

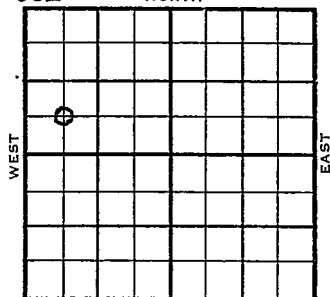

C SW NW

	ELEVATION	REPORT
1953	1633'	

11/11 Spudding
11/18 10" @ 550'
Drlg 2920'

12/16 Spud 11-9-53
Gas Well
TD 3888'
10" @ 550'
Oread 3654', Heeb 3702', Doug 3707',
Tonganoxie 3728'
DST 3810'-55' opn 1 hr, gas in 1 min
rec 6,640,000 cfg, 200' hgcm, 250#
TD 3888'
7" @ 3888'
36/ 3776-82 54/ 3784-96
66/ 3808-19 108/ 3822-40
Comp 13,933,000 cfgcd.

COMPLETED

Barber

County ~~Barton~~ State Kansas

Sec. 36 (Blk. Twp.) 32 (Sur. Rge.) 13W Map No.

Operator Superior Oil

Well No. 2 Farm Lonker "A"

Elev.	Location	C	SW	NE
-------	----------	---	----	----

62

FIRST REPORT

660 Ft. From S Line NW

650 Ft. From W Line Quarter

1st. Report NOV 11 1953

Completion

Remarks

Peel - Contr.

Spudding Date

Drig. Data

soudding

J. G. McGEHEE

Dear Joe,

Is this Barber County or Barton?

The County ~~x~~ listed says one and
the description says another.

You're a detective
aren't you?

(with tickets)

Luville

NOV 12 1953

Scout Cards	<u> </u>
Land Small Map	<u> </u>
Land Wall Map	<u> </u>
Tracings	<u> </u>
France Map	<u> </u>
Pierce Map	<u> </u>
Misc.	<u> </u>


Drig. Data

County Barber State Kansas
 Sec. 36 (Blk.) 32 (Sur.) 13W Map No.

Operator Superior Oil

Well No. 2 Farm Lonker "A"

Elev. 1633 Location C SW NW

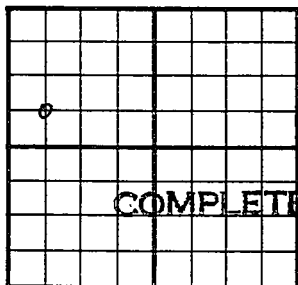

660 Ft. From S Line NW

660 Ft. From W Line Quarter

1st. Report

Completion DEC 16 1953

Remarks Medicine Lodge

Peel - Contr.

Spudding Date 11-9-53

Drlg. Data Gas well TD 3888

10" @ 550 Oread 3654 Heeb. 3702

Doug. 3707 Tonganoxie 3728 DST 3810-55

open 1 hr. gas in 1 min. rec. 6,640,000

cfg 200' hgcm 250# TD 3888 7" @ 3888

36/ 3776-82 54/ 3784-96 66/ 3808-19

108/ 3822-40 Comp. 13,933,000 cfgpd

J. G. McGEHEE

DEC 23 1953

Drig. Data

Scott-Cards
Land Cards
Tie
Mis.