
FORM 51

Barber KANSAS

Section 35 Township 32 Range 13 W

Well No. # 1 D. A. Lonker

Company Superior Oil

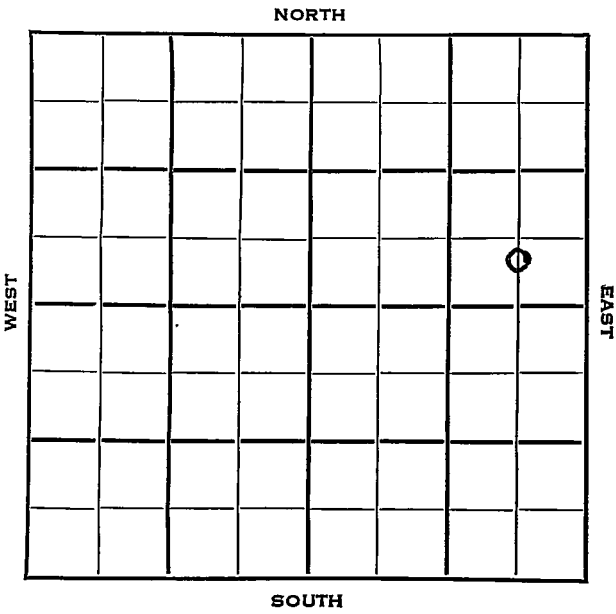

Barber KANSAS

SEC.	TWP.	R.
35	32	13 W

WELL NO. # 1

COMPANY D. A. Lonker FARM

CONTRACTOR Superior Oil

Peel

Medicine Lodge Pool


_____ Ft. from N. Line

460 Ft. from S. Line

660 Ft. from E. Line

_____ Ft. from W. Line

C SE NE

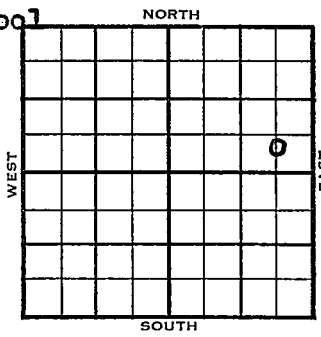

	ELEVATION	REPORT
1953	1598'	
10/21		Spud 10-16-53 10" @ 550 Drlg. 1286'
10/28 11/4		Drlg 3141' N.R.
11/24		Spud 10-16-53 Gas Well TD 3820' 10" @ 550' Elgin sd 3550', Heeb 3659', Tong 3734' DST 3738-57', opn 1 hr., rec. 125' gcm, 1120# DST 3757-80', opn 50 mins., rec. 6½ mcfg, 1230# TD 3820' DST 3780-3820', opn 57 mins., 3,200,000 gas, 1206# 7" @ 3748' CO to 3820 10 mcfg Comp. 8,163,000 gas, 1125# COMPLETED

DX-78

FORM 275 FOR SALE BY KANSAS BLUE PRINT CO.


County Barber State Kansas

Sec. 35 (Blk. Twp.) 32 (Sur. Rge.) 13W Map No.

Operator Superior Oil

Well No. 1 Farm D. A. Lonker

Elev. Location C SE NE

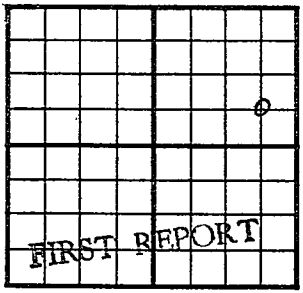

460 Ft. From S Line NE

660 Ft. From E Line Quarter

1st. Report OCT 21 1953

Completion

Remarks Peel - Contr.

Spudding Date 10-16-53

Drlg. Data Medicine Lodge Pool

10" @ 550 drlg. 1286

J. G. McGEHEE

FORM 275 FOR SALE BY KANSAS BLUE PRINT CO.


County Barber State Kansas

Sec. 35 (Blk. Twp.) 32 (Sur. Rge.) 13W Map No.

Operator Superior Oil

Well No. 1 Farm D. A. Lonker

Elev. 1598 Location C SE NE

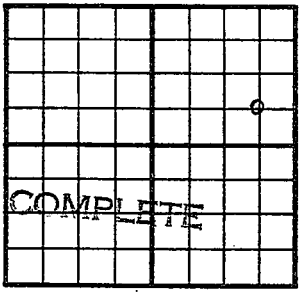

460 Ft. From S Line NE

660 Ft. From E Line Quarter

1st. Report

Completion NOV 2 4 1953

Remarks Medicine Lodge Pool

Peel - Contr.

Spudding Date 10-16-53

Drlg. Data Gas well TD 3820

10" @ 550 Elgin sd. 3550 Heeb. 3659

Tong. 3734 DST 3738-57 open 1 hr.

Rec. 125' gcm 1120# DST 3757-80

open 50 min. Rec. 6½ mcfg 1230#

TD 3820 DST 3780-3820 open 57 min.

3,200,000 gas 1206# 7" @ 3748

CO to 3820 10 mcfg

Comp. 8,163,000 gas 1125#

J. G. McGEHEE