

KANSAS

Barber

FORM 51 5M 1-42 PETROL

Section 2 Township 32 Range 13-W

Well No. #1 Marchell

Company Continental

							0

NORTH

WEST

EAST

SOUTH

KANSAS

Barber

Sec. 2 Twp. 32 R. 13-W

Well No. #1 Marchell Farm

Continental Company

Wildcat


 Ft. from N. Line

330 Ft. from S. Line

330 Ft. from E. Line

 Ft. from W. Line

Elev. 156.3

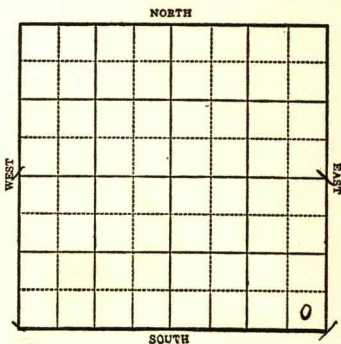

1943

R E P O R T

5/12 Location Sinclair Prairie
\$3250 Dry Hole
Ohio, \$1000 dry
hole money.

5/19 Derrick

5/26 10" @ 599'
T.D. 800' WOC.

6/2 Drlg. 2815

6/9 Drlg. 3755

6/16 K.C. 3749
Miss 4291
Sd ead oil 4294
Drlg. 4311

6/23 Viola 4546
T.D. 4565'
No shows.

ABANDONED

Barber

KANSAS

Map No. 93 Sec. 2 Twp. 32 R. 13WWell No. 1 Marchell

Continental


Company

ABANDONED

Contractor

SE/C

SECTION PLAT

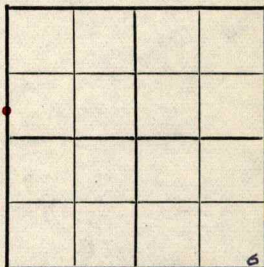

Ft. from N. Line

330 Ft. from S. Line330 Ft. from E. Line

Ft. from W. Line

WILDCAT

Location

Rig up

Drilling and Remarks:

*Viola 4546**No show*

RECORD

Cased _____ in., _____ ft.

Sand _____

Gas _____

Oil _____

Total Depth 4565

PRODUCTION

1st 24 hrs. Nat. _____

1st 24 hrs. after shot _____

Gas _____ Cu. Ft.

Dry Hole _____

Abandoned _____

Date

JUN 23 1943 19S. J. LEWIS Scout

KANSASMap No. 93 Sec. 2 Twp. 32 R. 13WWell No. 1 MarchellContinental


Company

FIRST REPORT

Contractor

SE/C

SECTION PLAT

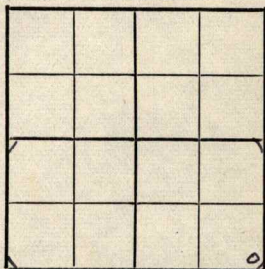

Ft. from N. Line

330 Ft. from S. Line330 Ft. from E. Line

Ft. from W. Line

WILDCAT

Location XXX

Rig up

Drilling and Remarks:

Sinclair Prairie Total Depth
\$3250 Dry HoleOhio, \$1000 Dry
Hole Money

RECORD

Cased _____ in., _____ ft.

Sand _____

Gas _____

Oil _____

Total Depth _____

PRODUCTION

1st 24 hrs. Nat. _____

1st 24 hrs. after shot _____

Gas _____ Cu. Ft.

Dry Hole _____

Abandoned _____

Date

MAY 12 1943

19

S. J. LEWIS

Scout