


19-32-13W

WELL LOG BUREAU—KANSAS GEOLOGICAL SOCIETY
502 East Murdock, Wichita, Kansas

Company- OLSON OIL COMPANY
Farm- Frank DeGeer No. 1

SEC. 19 T. 32 R13W
SE NW NW

Total Depth. 4577'
Comm. 12-1-60 Comp. 12-30-60
Shot or Treated.
Contractor. Patton Drlg.
Issued. 4-1-61

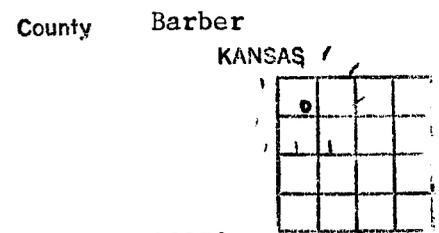

Elevation. 1837'

Production. 62,000,000 CFG

Figures Indicate Bottom of Formations.

CASING:	
10"	255'
8"	1198'
5"	4576'
red bed, shale	429
red bed shells	965
red bed, shale, shells	1075
shale, shells	1140
shale, shells, salt	1220
shale, shells	1990
lime & shale	2100
lime	2145
lime & shale	2284
lime	2535
lime & shale	2835
sandy lime w/shale	3010
sandy lime & shale	3178
lime & shale	3729
shale & lime	3840
sandy shale & lime	3949
lime & shale	4038
lime	4340
lime w/shale	4361
lime & shale	4467
lime w/shale	4500
lime & shale	4506
lime & chert	4542
cherty lime	4562
lime	4577
Total Depth	

TOPS: SCOUT	
Heebner	3850
Douglas	3905
Lansing	4027
Marmaton	4485
Mississippi	4522