


DX 78-1

Section 12 Township 32 Range 11W

Well No. 1 Lake

Purcell & Mull


Company -

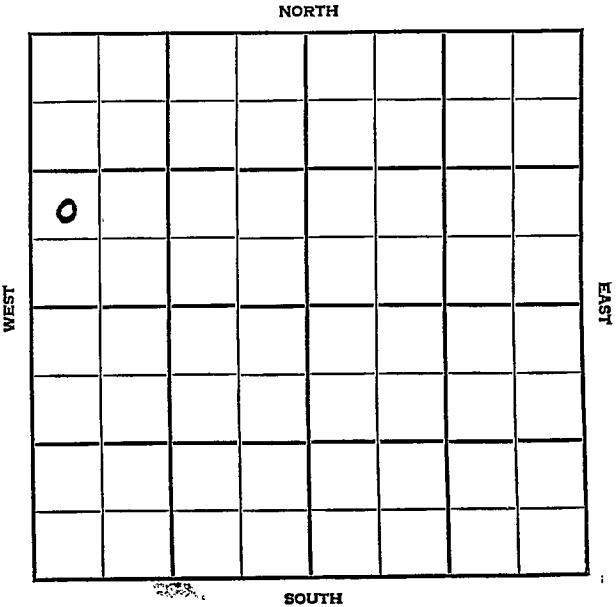

SEC.	TWP.	R.
12	32	14 W
WELL NO.		
# 1 Lake		
FARM		
COMPANY		
Purcell & Mull		
CONTRACTOR		

Burwick
Wildcat

_____ Ft. from N. Line
990 _____ Ft. from S. Line
_____ Ft. from E. Line
330 _____ Ft. from W. Line

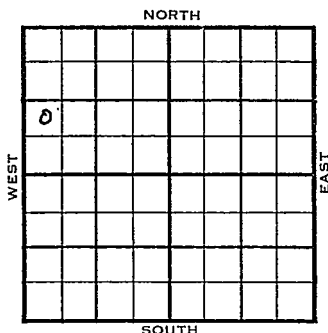

NW SW NW
Sohio F/O. DHM & Ac.

	ELEVATION	REPORT
1954	1648'	
8/4	Spud 7-24-54 8" @ 200 Drlg. 3640'	
9/29	Spud 7-24-54 SI gas well TD 4865 8" @ 200 Heeb 3663 Doug. 3819 DST 3821-30 open 1 hr gas in 1½ min, 3,220,000 CFG in 5 min, 4,450,000 CFG in 1 hr. rec 5' dk gr. hvy gr. oil, 45' SW. 1460# DST 3831-41 open 1 hr gas in 2 min 4,260,000 CFG in 20 min, rec 35' dist. 25' SW. 1700# Lans. 3850 DST 3895-3905 open 1 hr gas in 15 min rec 115' muddy oil, 60' clean oil 1080# DST 3926-43 open 1 hr rec 70' OCM O# DST 3964-82 open 1 hr rec 990' muddy & SGCSW 1300# DST 4077-91 open 1 hr, gas in 22 min, rec 210' HO & GCM, 55' thin oily mud, 65' oily muddy wtr. 1360# Massey 4276 Miss. 4344 DST 4349-57 open 1 hr rec 90' very thin SG & OCM 860# Viola 4615' Simp 4727'	

1954
9/29

(Information continued)

DST 4727-33 open $1\frac{1}{2}$ hr rec 45' mud
900# Arb. 4835

DST 4846-65, open 1 hr rec 380' GCW
1450# TD 4865 5" @ 4412

Schl tops: Heeb 3669' Doug 3808

Lans 3847 Miss 4342 Viola 4630

Simp 4724 Arb. 4835 TD 4861

CO 24/4070-76 B/SW & scum oil

500 A S/3 BO 31 BW 12 hr.

PB' 24/3892-98 1500 A S/60-70 BWPH

54/3808-24 2,500,000 CFG sd-frac.


10,000,000 CFG

Comp. Shut in gas well.

COMPLETED



County Barber State Kansas
 Sec. 12 (Blk. 32) (Sur. 14W) Map No. 14W
 Operator Purcell & Mull
 Well No. 1 Farm Lake
 Elev. 1648 Location NW SW NW

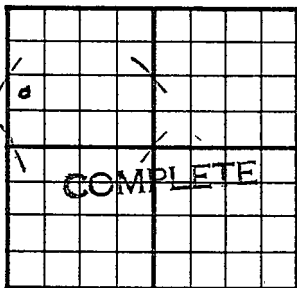

900 Ft. From S Line NW
330 Ft. From W Line Quarter
 Ist. Report Aug 4 1954
 Completion SEP 29 1954
 Remarks Sohio FO, DHM & AC
Burwick - Contr.
 Spudding Date 7-24-54

Drlg. Data SI gas well TD 4865 Wildcat
8" @ 200 Heeb. 3663 Doug. 3819

DST 3821-30 open 1 hr. gas in 1½ min.

3,220,000 cfg in 5 min. 4,450,000 cfg

in 1 hr. Rec. 5' dk. gr. hvy gr. oil

45' sw 1460# DST 3831-41 open 1 hr.

gas in 2 min. 4,260,000 cfg in 20 min.

Rec. 35' dist. 25' sw 1200# Lans. 3850

DST 3895-3905 open 1 hr. gas in 15 min.

Rec. 115' muddy oil 60' clean oil 1080#

DST 3926-43 open 1 hr. Rec. 70' ocm

0# DST 3964-82 open 1 hr. Rec. 990'

muddy sgcsw 1300# DST 4077-91 open

1 hr. gas in 22 min. Rec. 210' ho & gcm

55' thin oily mud 65' oily muddy wtr.

FABEN GILSTRAP

Drilg. Data

1360# Massey 4276 Miss. 4344

DST 4349-57 open 1 hr. Rec. 90' very

thin sg & ocm 860# Viola 4615

Simp. 4727 = DST 4727-33 open 1½ hr.

Rec. 45' mud 900# Arb. 4835 DST 4846-

65 open 1 hr. Rec. 380& gcw 1450#

TD 4865 5" @ 4412 SCHLUMBERGER TOPS

Heeb. 3669 Doug. 3808 Lans. 3847

Miss. 4342 Viola 4630 Simp. 4724

Arb. 4835 TD 4861 CO 24/ 4070-76

B/ sw & scum oil 500 A S/ 3 bo 31 bw

12 hr. PB 24/ 3892-98 1500 A

S/ 60 to 70 bwph 54/ 3808-24 2,500,000 cfr

sd-frac 10,000,000 cfr

Comp. shut in gas well

OCT 13 1954


Scout Cards
Land Small Map
Land Wall Map
Tracings
France Map
Pierce Map
Misc.

County **Barber** State **Kansas**
 Sec. **12** (Blk.) **32** (Sur.) **14W** Map No.
 (Twp.) (Rge.)

Operator **Furcell & Mull**

Well No. **1** Farm **Lake**

Elev. **1648** Location **NW SW NW**

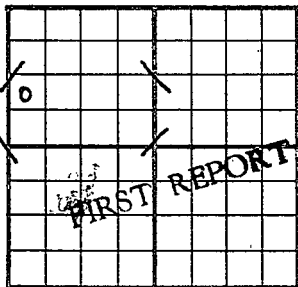

990 Ft. From **S** Line **NW**

330 Ft. From **W** Line Quarter

Ist. Report **AUG 4 1954**

Completion

Remarks **Sohio FO, DEM & AC**

Burwick - Contr.

Spudding Date **7-24-54**

Drig. Data

Wildcat

8" @ 200 drlg. 3640