

Barber


**KANSAS**

SECTION 18 TOWNSHIP 32 RANGE 14W

WELL NO. #1 Stumph-Smith "B"

COMPANY N C R A

NORTH NW NW SW

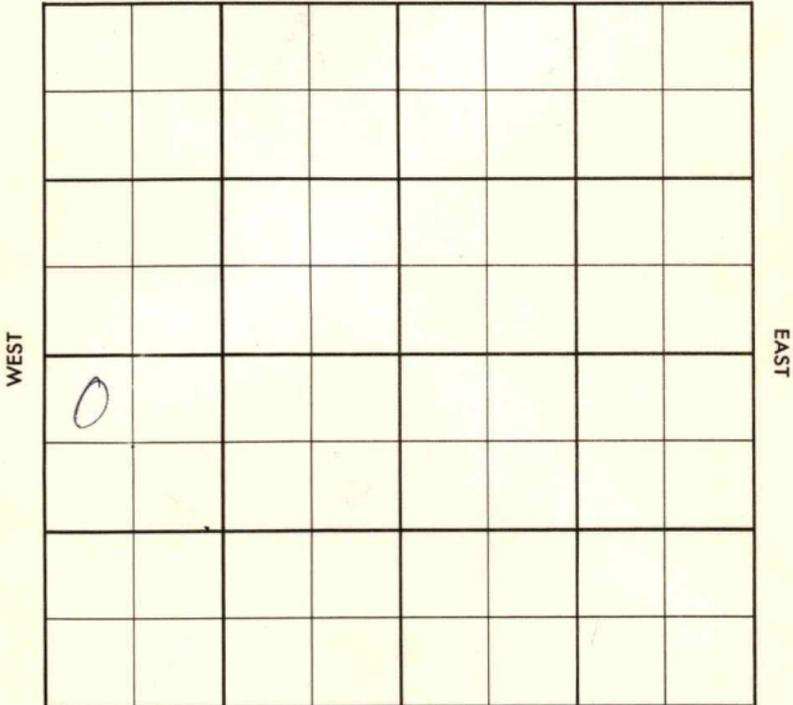

SOUTH

County Barber Elev. \_\_\_\_\_  
 Sec. 18 Twp. 32 Rge. 14W  
 Company N C R A  
 FarmName Stumph-Smith "B" No. 1

TOPS	DEPTH	LOG	DATUM
Anh.			
Tp.			
H.			
Tr.			
Dg.			
Bl.			
L.			
M.C.			
B.K.C.			
Ce.			
C.			
M.			
M.			
K.			
Mz.			
Mq.			
V.			
S.			
S.			
A.			
R.			
Pe.			
G.			
T.D.			

Loc. in Sec. \_\_\_\_\_

NW NW SW

Geol. \_\_\_\_\_

Contr. \_\_\_\_\_

Aylward

Pool \_\_\_\_\_

Stumph Ext.

FIRST REPORT	
o	
JAN 30 '57	

Date Comm. \_\_\_\_\_

RUR

~~26~~

Co.

Lse.

No.

Sec.

T.

R.

Co.

County Barber Elev. 1954  
 Sec. 18 Twp. 32 Rge. 14W  
 Company N C R A  
 Farm Name Stumph-Smith "B" No. 1

TOPS	DEPTH	LOG	DATUM	Loc. in Sec.
Anh.				NW NW SW
TP.				
H.	4013			
Tr.				
Dg. <u>sd</u>	4169			
BL.				
L.	4200			Geol.
K.C.				Contr.
B.K.C.				
Ce.				Aylward
C.				Pool
M.	4704			Stumph Ext.
M.				
K.				
Mz.				
Ma.				
V.	4927			
S.				COMPLETE
S.				
A.				
R.				
PE.				
G.				
T.D.	5078			MAR 20 '57

Loc.

No.

Sec.

Date Comm. 2-1-57

RUR FEB 9 '57 8 7/8 233/200

Ø 3415 FEB 13 '57 DST 4161-78

1hr G/20" rec 930' HG & 50CSW

+ 1270' SW FP 260-980 BHP

1520/20 Ø 4520 FEB 20 '57 DST

4704-30 1hr G/6" <sup>9a G 20 MCF</sup> rec 45' Md

FP 150- BHP 1660/20" DST

4729-60 1hr rec 15' 56 CM

BHP 710/20" DST 4759-4800

T

R

1hr rec 10' Md BHP 20/20"  
 DST 4889-98 1hr rec 5' Md  
 BHP 15/20" DST 4932-64

1hr no rec no press #  
 4996 FEB 27 '57 DST 5048-68 90"  
 rec 10' WM (S.O.) FP 25

BHP 155/20" DST 5069-78  
 1hr 1440' GIP + 45' VSOMD  
 FP 0-0 FBHP 330/20

5 1/2 5077/125 MAR 6 '57 5' CO  
 78/4710-23 ~~1/4~~ 52/4710  
 -23 G/1mmmed. ~~1/4~~ ga

775 MCFG Frac 10 x 10  
 ga 6,160 MCFG FOP 475  
 FTY 125 # MAR 13 '57 MAR 20 '57

ga 6,160 MCFG PD  
 comp. S.I. Gas. well