

22

32

14W

SECTION _____ TOWNSHIP _____ RANGE _____


#1 Elsea "C"

WELL NO. _____

COMPANY _____ Petroleum Inc. _____

NORTH

C NW SE

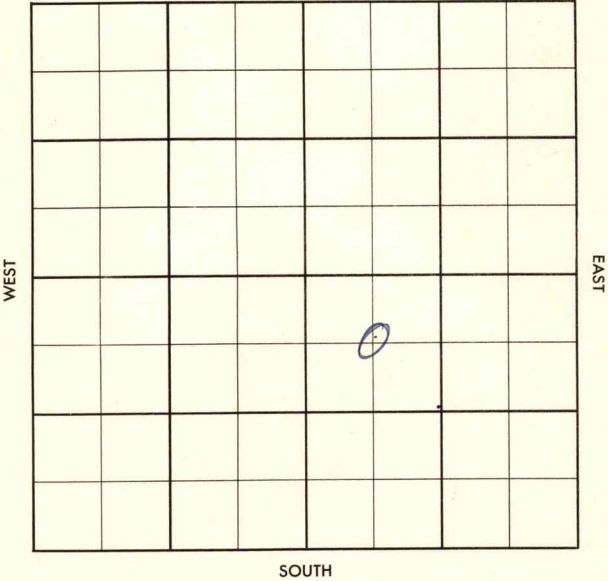

County Barber Elev. 1832 DFSec. 22 Twp. 32 Rge. 14WCompany Petroleum Inc.Farm Name Elsea "C" No. 1

TOPS

DEPTH

LOG

DATUM

Loc. in Sec.

C NW SE

Tp.

H.

Tr.

Dg.

Bl.

L.

K.C.

B.K.C.

Ce.

C.

M.

M.

K.

Mz.

Mq.

V.

S.

S.

A.

R.

P.C.

G.

T.D.

Geol.

Contr.

Garvey Tools

Pool

Elsea

FIRST REPORT

APR 3 '57

Date Comm. 3-30-57

8" @ 289/225, Drlg. 2630

26

County Barber Elev. 1832 DF
 Sec. 22 Twp. 32 Rge. 14W
 Company Petroleum Inc.
 Farm Name Elsea "C" No. 1

TOPS	DEPTH	LOG	DATUM	Loc. in Sec.
Anh.				C NW SE
TP.				
H.	3881			
Tr.				
Dg.	3948			
BL.				
L.	4061			Geol.
K.C.				
B.K.C.	4468			Cantr.
Ce. <u>Marm</u>	4478			Garvey Tools
C.				
M. <u>chert</u>	4520			
M. <u>LI</u>	4596			Pool
K.				Elsea
Mz.				
Mo.				
V.				
S.				
S.				
A.				
R.				
PE.				
G.				
T.D.	4670			

ABANDONED
 APR 24 '57
 0

Date Comm. 3-30-57

8" @ 289/225, Drlg. 2630 APR 10 '57 D 4410

APR 17 '57 DST 4509-65 1hr. 6/20"

re 30' 30E' 6CM + 60 HOE' 6CM

+ 60' 955y oil 1100/20 DST 4572

- 90 1hr 840 Gas re 60' 50E' 6C

WM + 60' 50CW BHP 1220/20

DST 4590-4605 1hr 30' Md BHP

0/20" DST 4605-70 op 40" re

55' Md BHP 0/20" DST 4505

37 2 hrs G/38" TSTM run
 45' 50' GCM + 365' HO' GCM
 980/30" DST 4507-47 DO PKR
 or 2 hrs G/40" TSTM run
 220' 00' GCM BHP 880/30"

APR 24 '59

DCA

~~###~~