


SECTION 34 TOWNSHIP 32 RANGE 14W

WELL NO. #1 Hull

COMPANY Mull Drlg. Co.

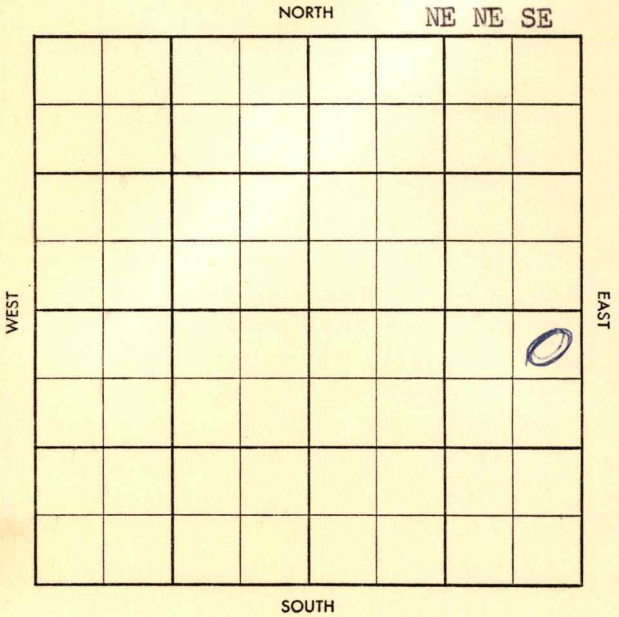

26

County Barber Elev. _____
Sec. 34 Twp. 32 Rge. 14W
Company Mull Drlg. Co.
Farm Name Hull No. #1

TOPS	DEPTH	LOG	DATUM	Loc. in Sec.
Anh.				NE NE SE
Tp.				
H.				
Tr.				
Dg.				
BL.				
L.				Geol.
K.C.				Contr.
B.K.C.				Co. Tools
Ce.				
C.				Pool
M.				Elsea
M.				
K.				
Mz.				
Mq.				
V.				
S.				
S.				
A.				
R.				
PE.				
G.				
T.D.				

FIRST REPORT
SEP 18 1951

Date Comm. MIRT

Co.
Lse.
No.
Sec.
T.
R.

26

FORM 513 SUNRAY

County Barber Elev. 1978 DF
 Sec. 34 Twp. 32 Rge. 14W
 Company Mull Drlg. Co.
 Farm Name Hull No. #1

TOPS	DEPTH	LOG	DATUM	Loc. in Sec.
Anh.				NE NE SE
Tp.				
H.		4048		
Tr.				
Dg.		4110		
BL.				
L.	4261			
K.C.				Geol.
B.K.C.				Contr.
Ce.				Co. Tools
C.				
M.	4764			Pool
M.				Elsea
K.				
Mz.				
Mq.				
V.				
S.				
S.				
A.				
R.				
Pe.				
G.				
T.D.	4803			

COMPLETE
 DEC 11 '57

Date Comm. MIRT SEP 25 '57 9 -17 -57 8" 200/150
IP 3530 OCT 2 '57 DST 4760-85
1 1/2 hrs G 1 1/2 ga 4.800 mcf
FP 960-860 BHP 1940-1700 IP a head
DST 4785-4803 2 hrs G 1 1/2" ext
250 mcf rec 60' gray oil 90'
GCMO 700 oil 90' O+t n w
FP 240-540 BHP 1780-1480
5" 4803/150 15 '57 CO 4801

152/ 4762 - 4800 500 MA

ext ga 5.000 MCF - unknown

dist OCT 23 '57 OCT 30 '57 NOV 6 '57

from est ga 18 to 20 m

SITP 600 SICP 1300 NOV 13 '57

NOV 20 '57

NOV 27 '57

DEC 4 '57

DEC 11 '57

crop Fl. 15.500 MCF

SICP 1300