

Section 2 Township 32 Range 11 WWell No. # 1 Lake "A"Company Purcell & Mill

NORTH

WEST

EAST

SOUTH

0

Barber KANSAS

SEC.	TWP.	R.
2	32	14W

WELL NO.

1 Lake "A"

FARM

COMPANY

Purcell & Mull

CONTRACTOR

Co. Tools


Semi-Wildcat

_____ Ft. from N. Line

330 _____ Ft. from S. Line

_____ Ft. from E. Line

330 _____ Ft. from W. Line

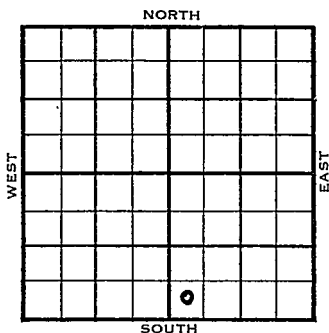

SW SW SE

	ELEVATION	REPORT
1954	1691'	

11/17

Spud 11-17-54
8" @ 190', WOC

1955
1/26

Spud 11-15-54
Temp. abd. TD 4701'
8" @ 190 Blaine sh. 3710'
Heeb 3729' Doug. 3846'
DST 3860-75, gas in 15 min, 390,000
CFG, rec 175' GCM, 1340# Lams 3893'
Miss. 4401' Maq. 4663'
DST 4666-77, open $\frac{1}{2}$ hr, rec 20' mud 0#
TB 4701' 5" @ 4016 CO 93/3841-72
wtr. CO to 3865 138/3841-62
frac. wtr. Temp. abd.

ABANDONED

County **Barber** State **Kansas**

Sec. **2** (Blk.) **32** (Sur.) **14W** Map No.

Operator **Purcell & Mull**

Well No. 1 Farm Lake "A"

Elev.	Location	SW	SW	SE
-------	----------	----	----	----

330 Ft. From S Line SE

/			/			330 Ft. From W Line	Quarter
---	--	--	---	--	--	---------------------	---------

[illegible]

PORT	Completion
------	------------

[illegible]

<u>Co. tools</u> <table border="1" style="width: 100%; height: 100%; border-collapse: collapse;"> <tr><td style="width: 10%;"></td><td style="width: 10%;"></td><td style="width: 10%;"></td><td style="width: 10%;"></td><td style="width: 10%;"></td><td style="width: 10%;"></td><td style="width: 10%;"></td><td style="width: 10%;"></td><td style="width: 10%;"></td><td style="width: 10%;"></td></tr> </table>											<u>Co. tools</u> .

Spudding Date 11-15-54

Drlg. Data Semi Wildcat

8" @ 190 WOC

FABEN GILSTRAP


County Barber State Kansas

Sec. 2 (Blk.) 32 (Sur.) 14W Map No.

Operator Purcell & Mull

Well No. 1 Farm Lake "A"

Elev. 1691 Location SW SW SE

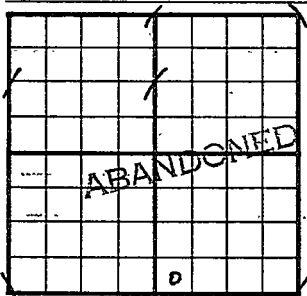

330 Ft. From S Line SE

330 Ft. From W Line Quarter

1st. Report

Completion JAN 26 1955

Remarks Semi Wildcat

Co. tools

Spudding Date 11-15-54

Drlg. Data Temp. abd. TD 4701

8" @ 190 Blaine sh. 3710 Heeb. 3729

Doug. 3846 DST 3860-75 gas in 15 min.

390,000 cfg Rec. 175' gcm 1340#

Lans. 3893 Miss. 4401 Maq. 4663

DST 4666-77 open $\frac{1}{2}$ hr. Rec. 20' mud

O# TD 4701 5" @ 4016 CO 93/ 3841-72

wtr. CO to 3865 138/ 3841-62 frac

wtr. Temp. abd.

FABEN GILSTRAP