


Section 7 Township 32 Range 14WWell No. #1 Stumph-SmithCompany N C R A

NORTH

WEST

EAST

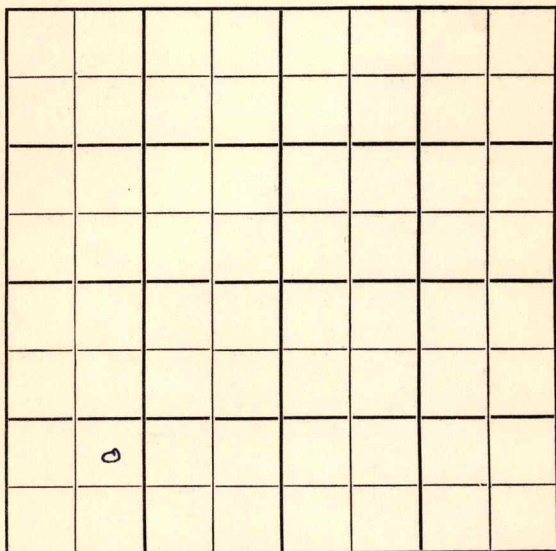

SOUTH



Sec. 7 Twp. 32 R. 14 W

Well No. # 1 Stumph-Smith Farm

NCRA

Company

Patton

Contractor

Wildcat

Ft. from N. Line

990


Ft. from S. Line

Ft. from E. Line

990

Ft. from W. Line

NE SW SW

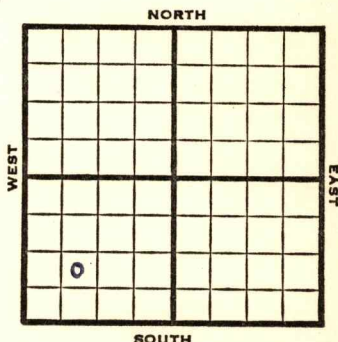

1952

Elev. 1947'

REPORT

5/21

Cellar & Pits

5/28

10" @ 403' Drlg. 1024'

6/11

Douglas 4161

DST 4162-69, 2 hrs. 260' O&GCM

260' SW 1100# Drlg. 4175'

6/17

KC 4185' Miss 11 4696'

Drlg. 4715'

6/25

V 4868

Simp. 4961

DST 4947-70 2 hrs. gas blew

40 Bf out of pipe mostly oil

DST 4963-70, 2 hrs. gas in 10"

3625' oil 1075# 7" @ 4963

RTD 4970

7/2

Spud 5-24-52 Oil well TD 4970'

10" @ 403' Doug. 4161'

DST 4162-69 open 2 hr. rec 260' O & GCM

260' SW KC 4185' Miss 4696'

Viola 4868' Simp. 4961'

DST 4947-70 open 2 hr. gas blew 40

BF out of hole, mostly oil

DST 4963-70 open 2 hr. gas in 10 min.

rec 3625' oil. 7" @ 4963' TD 4970'

FU 2500' oil & OCM 3 hr. HFO 14 hr.

S/93 BO 6 hr.

Comp. 509 BOPD

COMPLETED

Operator N. C. R. A.

Well No. **1** Farm **Stumph-Smith**

Elev.		Location	NE SW SW
-------	--	----------	----------

990 Ft. From S Line SW

990 Ft. From W Line Quarter

1st. Report **MAY 21 1952**

Completion

Remarks

Patton - Contr.

Spudding Date _____

Drig. Data Wildcat

Cellar and pits

J. G. McGENEE

J. G. McGEHEE