


Section 7 Township 32 Range 14 W

Well No. # 2 Stump-Smith

Company NCRA

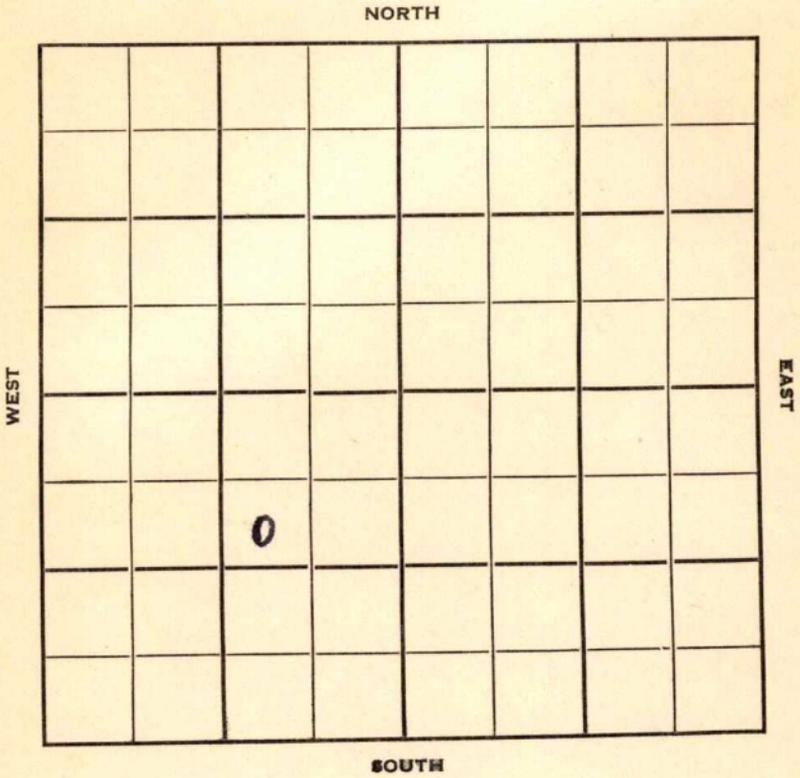

Sec. 7 Twp. 32 R. 14W

Well No. #2 Stump - Smith Farm _____

N G R A Company _____

Contractor _____


990 Ft. from N. Line

Ft. from S. Line

990 Ft. from E. Line

Ft. from W. Line

SW NE SW

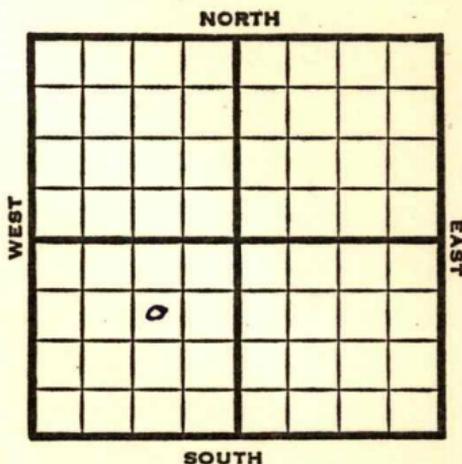

1952

Elev. 1920' REPORT

- 10/8 Location
- 10/15 "
- 10/22 Drlg. 500'
- 10/29 Drlg. 2560'
- 11/5 Shut down 3953'
- 11/12 **Douglas 4130'**
DST 4115-36, 2 hrs, 160' HO& GCM, 60'
SW 1195#
Drlg. 4255'
- 11/20 **V 4818' Simp sha 4935' Simp sd 4943'**
Drlg. 4953'
- 11/27 **Arb. 5053,**
RTD 5110
- 12/4 5" @ 5110'
- 12/11 Rust
- 12/18 CO 5081 4/4961-62 S/1 BW 1 Hr. / SO
4/4960-61 S/2 BW / 1/3 BO 2 Hrs. PB
4960 7/4958-60 S/4 BF 2 Hrs.
- 12/25 " " " " " "
- 1/1 NR
- 1/8 NR

OVER

1953
1/23

Spud 10-19-52 Oil well TD 5110'
8" @ 496 Doug 4130'
DST 4115-36 open 2 hr rec 160' HO
& GCM, 60' SW 1195#
Viola 4818'

DST 4913-33 failed.
DST 4913-33 open 2 hr. rec 40' mud
Off

Simp. sh. 4935' Simp sd 4943'
DST 4931-48 open 2 hr. rec 30' OCM
300' gassy oil, 30' SW 1575#
DST 4948-53 open 2 hr. rec 45' mud
620' oil, 170' SW 1620#

Arb. 5053' TD 5110' 5" @ 5110
CO to 5081 4/4961-62 S/1 BW 1 hr.
4/4960-61 S/2 BW 1/3 BO 2 hr.
PB 4960 7/4958-60 S/4 BF 2 hr.
FU 3100' fluid 21 hr. 39% oil
S/30 BF 40% oil 8 hr. PB 4959'
S/1 BO 1½ BWPB 39/4953-58 22 BF
8 hr. 50% oil S/1½ BO 1½ BWPB 13 hr.
Comp. 36 BOPD 36 BW

COMPLETED

Drlg. Data

PB 4959 S/ 1 bo $1\frac{1}{2}$ bwph 39/ 4953-58

22 bf 8 hr. 50% oil S/ $1\frac{1}{8}$ bo $1\frac{1}{8}$ bwph

13 hr. Comp. 36 bopd 36 bw

JAN 29 1953

Scout Cards
Land Small Map
Land Wall Map
Tracings
France Map
Pierce Map
Misc.

mm

5