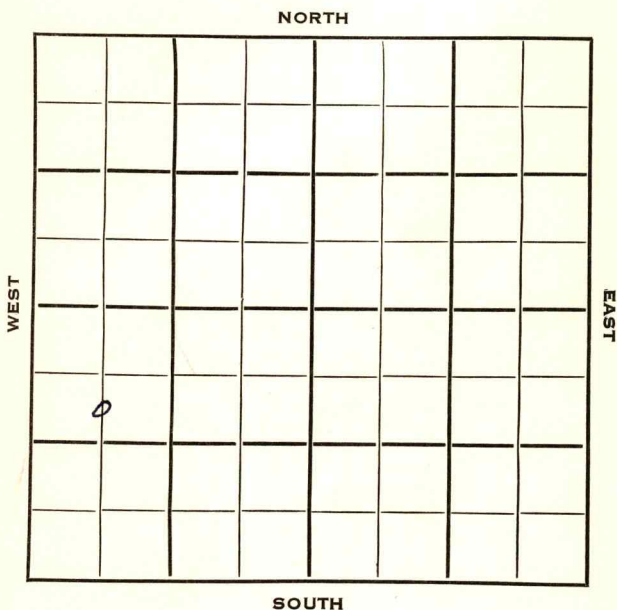


Barber

KANSAS

Section 7 Township 32 Range 14WWell No. #3 Stumph - SmithCompany N C R A

Barber

KANSAS

Sec. 7 Twp. 32 R. 14W

Well No. #3 Stump-Smith Farm

N C R A

Company

Burwick

Contractor


990 Ft. from N. Line

Ft. from S. Line

Ft. from E. Line

660 Ft. from W. Line

C S L NW SW

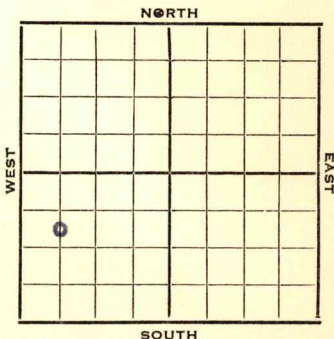

1953 Elev. 1942' REPORT

2/25 Spud 2-19-53
8" @ 491
Dr1g. 2395

3/12 Dr1g.

3/19 Lans 4187, V 4840, Simp 4960
RTD 4969
5" @ 4967'

3/26 CO 4969' DD 4970' S/8-3/4 BO
4 hrs. DD 4972 S/16 BO 4 1/2 hrs.
G. 28

4/2 S/19 BO / trace wtr 13 Hrs.

4/9 "

4/16 NR

4/23 "

4/30 "

5/6 Spud 2-19-53

Oil Well

TD 4972'

8" @ 491'

Anhy 835, Doug 4161,

DST 4147-63 opn 2 hr, rec 240' gcm
270' sw, 1183# Lans 4187, Viola 4840,
Simp 4960

TD 4969

5" @ 4967'

CO to 4969' DD 4970 S/ 8 3/4 bo 4
hr. DD 4972 S/ 16 bo 4 1/2 hr. S/ 19 bo
13 hr.

Comp. 22 bopd 6% wtr.

COMPLETED

County Barber State Kansas

Sec. 7 (Blk. Twp.) 32 (Sur. Rge.) 14W Map No.

Operator N C R A

Well No. 3 Farm Stumph - Smith

Elev. 1942 Location C S L NW SW

990 Ft. From N Line SW

660 Ft. From W Line Quarter

1st. Report

Completion MAY 6 1953

Remarks

Burwick - Contr.

Spudding Date 2-19-53

Drig. Data Oil well 1 TD 4972

8" @ 491 Anhy 835 Doug. 4161

DST 4147-63 open 2 hr. Rec. 240' gcm

270' sw 1183# Lans. 4187

Viola 4840 Simp. 4960 TD 4969

5" @ 4967 CO to 4969 DD 4970

S/ 8 3/4 bo 4 hr. DD 4972 S/ 16 bo

4 1/2 hr. S/ 19 bo 13 hr.

Comp. 22 bopd 6% wtr.

J. G. McGEHEE

County **Barber** State **Kansas**Sec. **7** (Blk.) **32** (Sur.) **14W** Map No.Operator **N C R A**Well No. **3** Farm **Stumph - Smith**Elev. Location **C S L NW SW**990 Ft. From **N** Line **SW**660 Ft. From **W** Line **Quarter**1st. Report **FEB 25 1953**

Completion

Remarks

Burwick - Contr.Spudding Date **2-19-53**

Drlg. Data

8" @ 491 drlg. 2395

J. G. McGEHEE