

State Geological Survey

WICHITA BRANCH

KANSAS DRILLERS LOG

API No. 15 — 007 — 20,546-A⁰⁰⁰¹
 County Number

S. 17 T. 32S R. 15W
 Loc. 660' FNL & 1650' FEL
 County Barber

Operator
 Texas Oil & Gas Corp.

Address
 200 W. Douglas, Suite 300, Wichita, Kansas 67202


Well No. 1 Lease Name Rusk "D" (OWWO)

Footage Location
 660 feet from (N) (S) line 1650 feet from (E) (W) line

Principal Contractor H-30 Drlg., Inc. Geologist N/A

Spud Date 7-13-78 Total Depth 4835' P.B.T.D. N/A

Date Completed 10-07-78 Oil Purchaser N/A

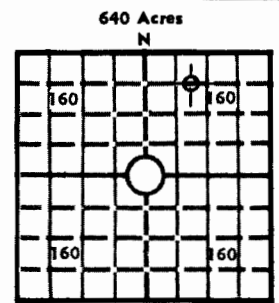

Locate well correctly
 Elev.: Gr. 1941'
 DF 1946' KB 1949'

CASING RECORD

Report of all strings set — surface, intermediate, production, etc.

Purpose of string	Size hole drilled	Size casing set (in O.D.)	Weight lbs/ft.	Setting depth	Type cement	Sacks	Type and percent additives
Surface	12 1/4"	8-5/8"		1017'			
Production		4 1/2"	10.5#	4801'	50/50 Pozmix	125	10% NaCl

LINER RECORD

PERFORATION RECORD

Top, ft.	Bottom, ft.	Sacks cement	Shots per ft.	Size & type	Depth interval
N/A	N/A	N/A			
TUBING RECORD			N/A	N/A	N/A
Size	Setting depth	Pecker set at			
2-3/8"	4786'	N/A			

ACID, FRACTURE, SHOT, CEMENT SQUEEZE RECORD

Amount and kind of material used	Depth interval treated
4,000 gal. acid	O.H. (4801-35')

INITIAL PRODUCTION

Date of first production N/A	Producing method (flowing, pumping, gas lift, etc.) N/A
RATE OF PRODUCTION PER 24 HOURS	Oil N/A bbls. Gas N/A MCF Water N/A bbls. Gas-oil ratio N/A CFPB
Disposition of gas (vented, used on lease or sold) N/A	Producing interval (s) N/A

INSTRUCTIONS: As provided in KCC Rule 82-2-125, within 90 days after completion of a well, one completed copy of this Drillers Log shall be transmitted to the State Geological Survey of Kansas, 4150 Monroe Street, Wichita, Kansas 67209. Copies of this form are available from the Conservation Division, State Corporation Commission, 3830 So. Meridian (P.O. Box 17027), Wichita, Kansas 66217. Phone AC 316-522-2206. If confidential custody is desired, please note Rule 82-2-125. Drillers Logs will be on open file in the Oil and Gas Division, State Geological Survey of Kansas, Lawrence, Kansas 66044.

Operator

DESIGNATE TYPE OF COMP.: OIL, GAS, DRY HOLE, SWDW, ETC.:

Texas Oil & Gas Corp.

Well No.

1

Lease Name

Rusk "D"

Dry Hole

S 17 T 32S 15W

WELL LOG

Show all important zones of porosity and contents thereof; cored intervals, and all drill-stem tests, including depth interval tested, cushion used, time tool open, flowing and shut-in pressures, and recoveries.

SHOW GEOLOGICAL MARKERS, LOGS RUN, OR OTHER DESCRIPTIVE INFORMATION.

FORMATION DESCRIPTION, CONTENTS, ETC.	TOP	BOTTOM	NAME	DEPTH
Onaga	3152	-1203		
Stotler	3340	-1391		
Kanwaka Sh	3904	-1955		
Heebner	4078	-2129		
Lansing	4250	-2301		
B/Kansas City	4642	-2693		
Mississippi	4788	-2839		
TD	4835	-2886		
DST #1, 4798-4835', (Mississippi) w/results as follows: Mis-run.				
DST #2, 4794-4835', (Mississippi) w/results as follows: IFP/30": 158-285#, strong blow ISIP/65": 1238# FFP/45": 328-381#, GTS/35", TSTM FSIP/90": 1008# Rec 330' GCM & 300' GCMW.				

USE ADDITIONAL SHEETS, IF NECESSARY, TO COMPLETE WELL RECORD.

Date Received

Harold A. Brown

HAROLD A. BROWN Signature

District Geologist

Title

October 26, 1978

Date

COMPANY Texas Oil & Gas Corp.

SEC. 17 T. 32S R. 15W
LOC. 660' PNL & 1,650' PNL

FARM Rusk "D"

NO. 1 OWWO

COUNTY Barber

ROTARY TOTAL DEPTH 4,835'
COMM. July 11, 1978
CONTRACTOR H-30, Inc.
ISSUED July 24, 1978

COMP. July 16, 1978

CASING

10 3/4" Set at 1,017' by prior operator
8 5/8" Set at 1,017' by prior operator
5 1/2" Set at 4,801' cemented w/125 sxs cement
4 1/2" Set at 4,801' cemented w/125 sxs cement

ELEVATION 1,946 K.B.

FIGURES INDICATE BOTTOM OF FORMATIONS

Old Rotary Total Depth	4,835'
Washed down to	4,835'
Rotary Total Depth	4,835'

I hereby certify the above and foregoing to be a true and correct log of the above described well as shown by the drilling reports.

H-30, Inc.

Dean Britting
Dean Britting

State of Kansas }
County of Sedgwick } ss:

Subscribed and Sworn to before me a Notary Public in and for said county and state this 24th day of July, 1978.



Elsie Willison
Elsie Willison - Notary Public

My Commission Expires: