


33 - 32 - 15 W

WELL LOG BUREAU—KANSAS GEOLOGICAL SOCIETY
500 East Murdock, Wichita, Kansas

Company- TIME PETROLEUM CO.
Farm- DeGeer "A" No. 1

SEC. 33 T. 32 R.15W
C NW NW

Total Depth. 5183'
Comm. 12-6-61 Comp. 12-23-61
Shot or Treated.
Contractor. Strata Drilling, Inc.
Issued. 3-17-62

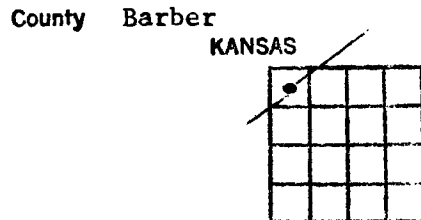

CASING:
13 3/8" 203' cem w/80 sx.

Elevation. 1948' RB

Production. Dry

Figures Indicate Bottom of Formations.

gyp & red bed	65
red bed	203
red bed & shale	1100
shale & shells	1765
shale & lime	2460
lime	2570
lime & shale	2960
shale	3185
shale & lime	4179
lime	4740
lime & chert	4789
lime	4808
lime & shale	4868
lime	4938
lime & shale	4998
lime	5030
lime & chert	5052
lime	5107
lime & shale	5145
shale & sand	5178
lime & shale	5183
Total Depth	

TOPS: SCOUT	
Heebner Shale	4011
Lansing	4182
Conglomerate	4746
Mississippi Chert	4751
Kinderhook Lime	4890
Viola	4962
Simpson Shale	5112
Simpson Sand	5128