


Barber

KANSAS

SECTION 3 TOWNSHIP 32 RANGE 15W

WELL NO. #3 Skinner "D"

COMPANY Aylward

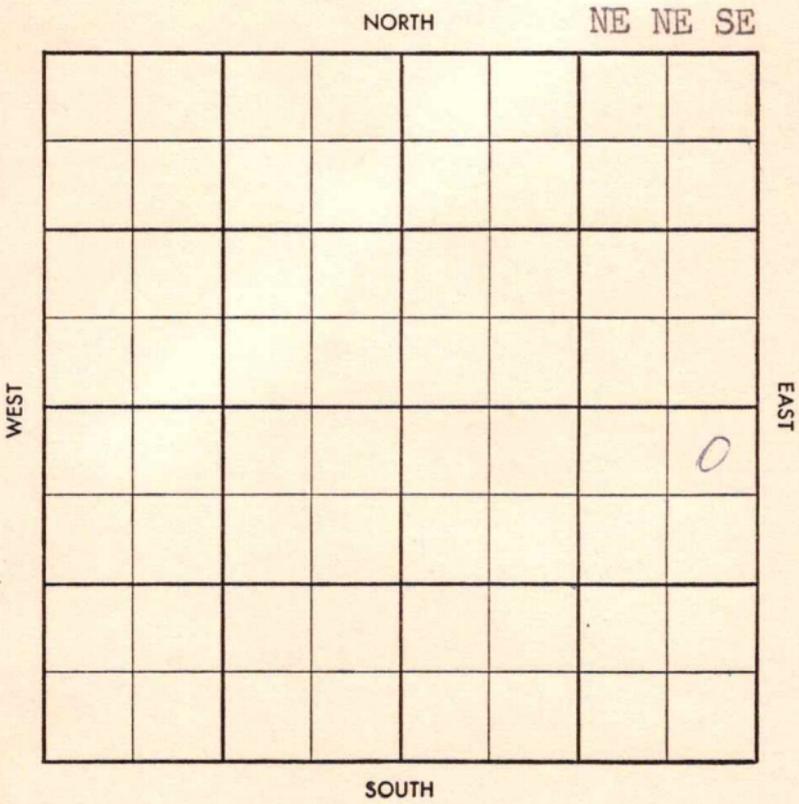

~~24~~

CO. ~~Barber~~ ELEV. _____
SEC. 3 TWP. 32 RGE. 15W
COMPANY Aylward NO. 3

FIRST REPORT

OCT 16 '57

FARM Skinner "D"

LOC. NE NE SE

| | |
|--|--|
| | |
| | |
| | |
| | |
| | |
| | |
| | |
| | |
| | |
| | |

GEOL. _____

CONTR. Co. tools

POOL Donald

SPUD _____

Location

CO.

LSE.

NO.

SEC.

TWP.

RGE.

26

S-513-A

CO. ~~Barber~~ ELEV. 1993
SEC. 3 TWP. 32 RGE. 15W
COMPANY Aylward NO. 3

COMPLETE
DEC 11 '57

FARM Skinner "D"

LOC. NE NE SE

| | |
|--|--|
| | |
| | |
| | |
| | |
| | |
| | |
| | |
| | |
| | |
| | |

GEOL.
CONTR. Co. tools
POOL Donald
SPUD 10-17-57
Location
8" 225/190
D 3150
Ø 4604
Hb 4099 L 4280
M 4816 DST 4816

- 80 60" G/1" ga 378 MCF/15"
200' oil/FPI 420/470 BWP
1625 P

DST 4880 - 4926 60"
14" M N Prec RTD 4926

5" 4925/100 NOV 13 '57 WOST
NOV 20 '57 48/4872-80 Flo 16

BOPh 2hrs
DEC 11 '57 Flo 37 BOPd NW

CO.
NO.
SEC.
TWP.
RGE.