


Barber

KANSAS

SECTION 2 TOWNSHIP 32S RANGE 15W

WELL NO. #3 Skinner "C"

COMPANY NCRA & Aylward

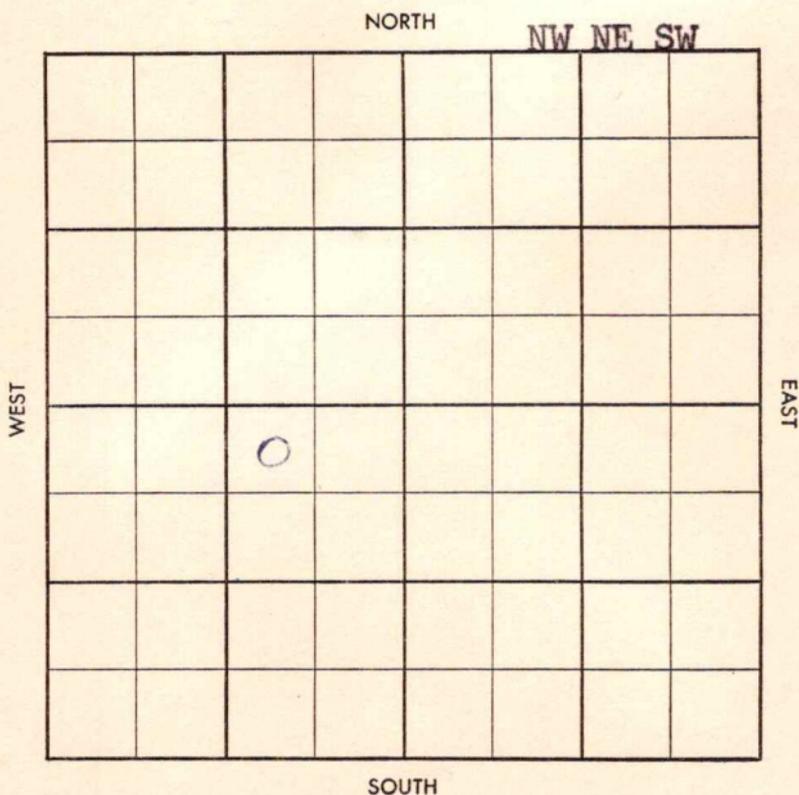

~~Water~~ ~~Foot~~  
✓ ~~26~~

County Barber Elev. \_\_\_\_\_  
Sec. 2 Twp. 32 Rge. 15W  
Company NCRA & Aylward  
Farm Name Skinner "C" No. 3

TOPS	DEPTH	LOG	DATUM
Anh.			
Tp.			
H.			
Tr.			
Dg.			
B.L.			
L.			
K.C.			
B.K.C.			
Ce.			
C.			
M.			
M.			
K.			
Mz.			
Mq.			
V.			
S.			
S.			
A.			
R.			
Pf.			
G.			
T.D.			

Loc. in Sec. \_\_\_\_\_  
NW NE SW  
Geol. \_\_\_\_\_  
Contr. \_\_\_\_\_  
Aylward  
Pool \_\_\_\_\_  
Donald



Date Comm. \_\_\_\_\_  
Location  
\_\_\_\_\_  
\_\_\_\_\_  
\_\_\_\_\_  
\_\_\_\_\_  
\_\_\_\_\_  
\_\_\_\_\_

Twp. ~~XXXX~~ Pool ~~XXXX~~  
 Co. ~~XXXX~~ Facet ~~XXXX~~

S-513-B

County Barber Elev. 19600 of 1963 RB  
 Sec. 2 Twp. 32 Rge. 15W  
 Company NCRA & Aylward  
 Farm Name Skinner "C" No. 3

TOPS	DEPTH	LOG	DATUM
Anh.			
Tp.			
H.	4083	4076	
Tr.	4099	4092	
Dg.	4120	4112	
B.L. <u>Dg sd</u>	4145	4142	
L.	4260	4255	
K.C.			
B.K.C.	4715	4699	
Ce. <u>Massey</u>	4728	4721	
C. <u>sd</u>	4799	4790	
M.	4823	4815	
M.			
K.	4903	4904	
Mz.			
Mq.			
V.			
S.			
S.			
A.			
R.			
Pf.			
G.			
T.D.	4935	4929	

Loc. in Sec. NW NE SW  
 Geol. \_\_\_\_\_  
 Contr. Aylward  
 Pool Donald

COMPLETE  
 0  
 JUL 9 '58

Date Comm. 5-24-58 8" 200/75  
 Location 21 58 MAY 28 58 2140 JUN 3 '58  
3750 JUN 11 '58 DST 4714-38 1hr  
12' M FP 25-25 BHP 115-45/20"  
4738 JUN 18 '58 DST 4796-4840 60"  
g 1/5" ga 439 meff 115" 465 meff 160"  
20' gcm FP 120-130 BHP 1738  
-1658/20" DST 4840-65 60"  
g 1/7" ga 76 meff 110" 44 meff 115"  
F10/15" 4965 011 FP 315-912

Co.  
 Sec.  
 No.  
 Sec.

BHP 1652 - 1528/20" DST 4865-95  
 23" g/4" ga 362 met/15" 290  
 met/10" oil & surf 15 in 4895  
 oil FP 870 - 1172 BHP 1534-1525/20  
 5" 4932/105 SLM ~~4~~  
 6' up Hole JUN 25 '58 30/4888-99  
 250A F1025 130 + 2070 LdW  
 2 hrs F10 28 1/2 BOPH LdW  
 5 hrs FCP 200 SICP 400  
 tstg JUL 2 '58 JUL 9 '58 P256230 +  
 trw 24 hrs

+