
Barber KANSAS

SECTION 3 TOWNSHIP 32 S RANGE 15 W

WELL NO. # 1 Skinner "D"

COMPANY Aylward Drlg.

SE SE NE

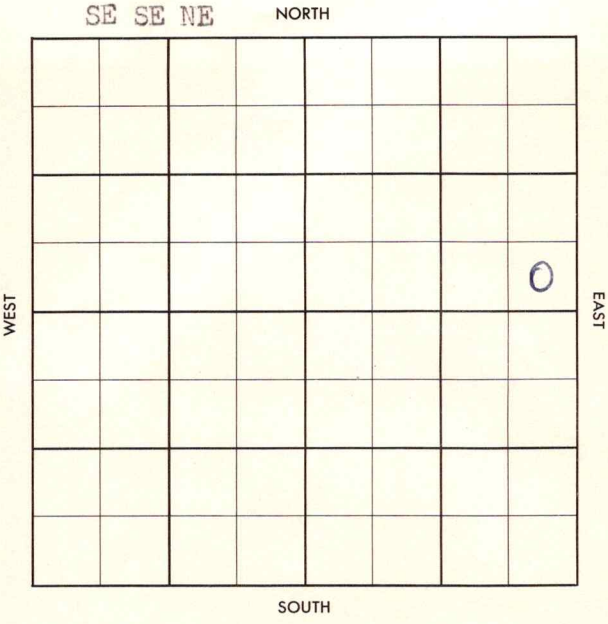

FORM 504-3 SUNRAY

FORM 513 SUNRAY

County Barber Elev.

Sec. 3 Twp. 32 Rge. 15W

Company Aylward Drlg.

Farm Name Skinner "D" No. 1

TOPS	DEPTH	LOG	DATUM
Anh.			
Tp.			
H.			
Tr.			
Dg.			
Bl.			
L.			
K.C.			
B.K.C.			
Ce.			
C.			
M.			
M.			
K.			
Mz.			
Mo.			
V.			
S.			
S.			
A			
R.			
P€.			
G.			
T.D.			

Loc. in Sec. SE SE NE

Geol.

Contr. Co. Tools

Pool Donald

FIRST REPORT

AUG 28 57

Date Comm. 8-25-57

8" @ 200/150, Drlg. 1050

24

Co. Lse. No. Sec. T. R.

FORM 513 SUNRAY

~~1981 KB~~
1981 RB.

County Barber — Elev. 1979 DF

Sec. 3 — Twp. 32 — Rge. 15W

Company Aylward Drlg.

Farm Name Skinner "D" — No. 1

TOPS	DEPTH	LOG	DATUM
Anh.			
Tp.			
H.	4077		
Tr. B Qual	4131		
Dg. Sd	4140		
Bl.			
L.	4259		
K.C.			
B.K.C.	4692		
Ce.			
C.			
M.	4798		
M.			
K.			
Mz.			
Mg.			
V.			
S.			
S.			
A			
R.			
P€.			
G.			
T.D.	4903		

Loc. in Sec. SE SE NE

Geol.

Contr. Co. Tools

Pool Donald

COMPLETE

NOV 6 '57

Date Comm. 8-25-57

8" @ 200/150, Drlg. 1050 SEP 4 57

SEP 1 1 57 DST 4800 - 30 Dual Pkr

G/2" gg 734 mcf/5" 390

mcf/30" no fld rec BHP

1550 DST 4830-60 ½ hr

G/1½" gg 3.880 mcf/20" 100'

Mdy oil FP 675-745 BH

1625 - 1610/20" 5" 4903/151

ran log w/ct SEP 25 57

Co. Lse. No. Sec. T. R.

FORM 513-1 SUNRAY

1st / 4830-66 frac

OCT 2 '57 Ga 11,500 mcf

OCT 9 '57 11,800 mcf OCT 15 '57

OCT 23 '57 NOV 6 '57 CP 1445

TP 1425

M 4830-66

TD 9903

3-32-15W