

KANSAS


FORM 51 5M PETROL

Barber

Section 11 Township 32 Range 15W

Well No. #1 Skinner

Company Champlin Ref.

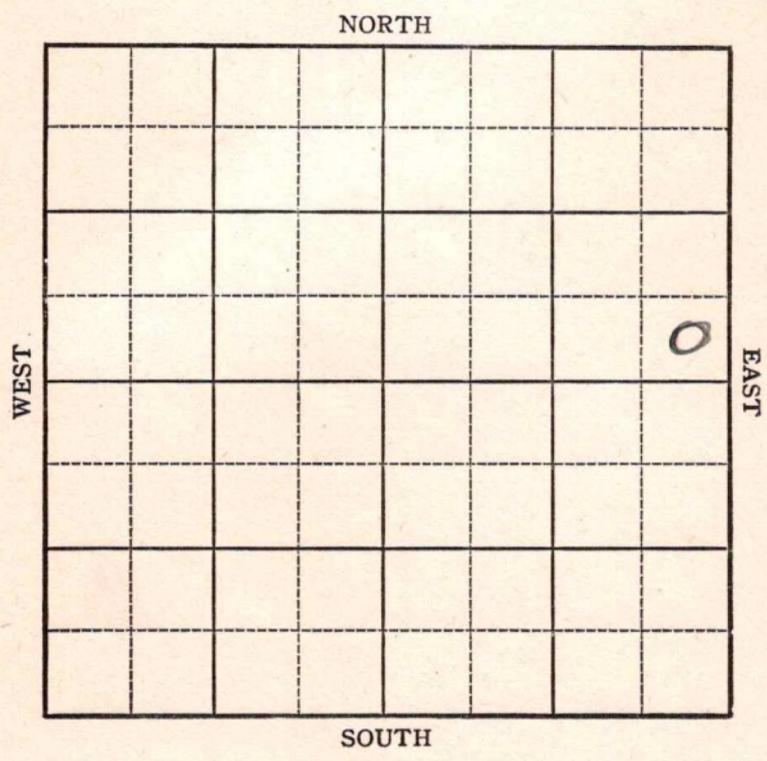

Barber

Sec. 11 Twp. 32 R. 15W

Well No. #1 Skinner Farm
Champlin Ref. Company

Wildcat


_____ Ft. from N. Line

330 Ft. from S. Line

330 Ft. from E. Line

_____ Ft. from W. Line

Elev. 1983

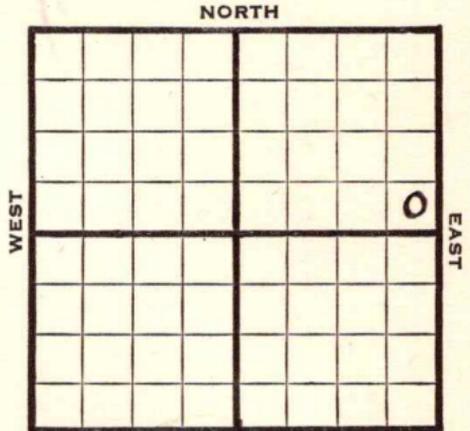

REPORT

1944

3/22
3/29

Location
"

4/5

Drlg. 470'

4/12

Brlg. 1110'

4/19

10" @ 480
Drlg. 3280

4/26

Drlg. 4470'

5/3

lans 4423
Miss 4717
Viola 4958
Drlg. 4974'

5/10

Arb. 5165
TD 5200'

ABANDONED

KANSAS

Map No. 93 Sec. 11 Twp. 32 R. 15W

Well No. 1 Skinner

Champlin Ref. Company

FIRST REPORT Contractor

SE NE

SECTION PLAT

_____ Ft. from N. Line

330 Ft. from S. Line

330 Ft. from E. Line

_____ Ft. from W. Line

			o

Wildcat

Location X

Rig up _____

Drilling and Remarks:

RECORD

Cased _____ in., _____ ft.

Sand _____

Gas _____

Oil _____

Total Depth _____

PRODUCTION

1st 24 hrs. Nat. _____

1st 24 hrs. after shot _____

Gas _____ Cu. Ft.

Dry Hole _____

Abandoned _____

Date

MAR 22 1944 19

S. J. LEWIS Scout

