


Section 22 Township 32 Range 15-"

Well No. #1 Hilderbrand "B"

Company Chanplin Oil

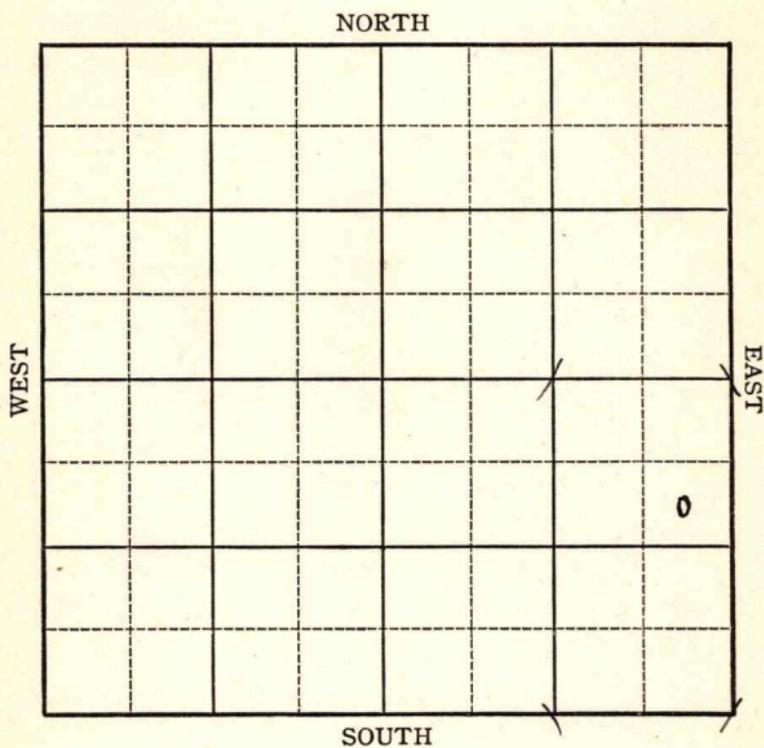

Sec. 22 Twp. 32 R. 15-W

Well No. #1 Hilderbrand "B" Farm

Champlin Oil Company


990 Ft. from N. Line

_____ Ft. from S. Line

330 Ft. from E. Line

_____ Ft. from W. Line

Elev. 1946

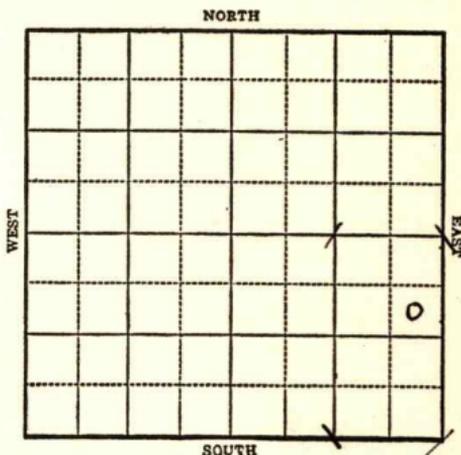

1943

R E P O R T

- 5/19 Derrick
- 5/26 396' Run 10"
- 6/2 10" @ 396
Drlg. 2700'
- 6/9 Drlg. 3800
- 6/16 **K. C. 4290**
Drlg. 4580'
- 6/23 **Miss 4774**
Viola 4982
Coring 4991 $\frac{1}{2}$
- 6/30 T.D. 5110'
5" @ 108' Rust
- 7/7 " " "
- 7/18 **Viola 4982**
5" @ 5108'
T.D. 5110'
31 shots 4980-95
25 M. Gas

COMPLETED

KANSAS

Barber

Map No. 93 Sec. 22 Twp. 32 R. 15W

Well No. 1 Hilderbrand "B"

Champlin Oil Company

COMPLETED Contractor

SE NE SE


SECTION PLAT

990 Ft. from N. Line

_____ Ft. from S. Line

330 Ft. from E. Line

_____ Ft. from W. Line

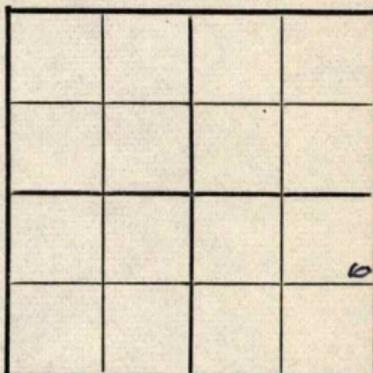

DEERHEAD POOL

Location _____

Rig up _____

Drilling and Remarks:

Viola 4982
5-205108
31 shot to 4950-95

25 M Gas

RECORD

Cased _____ in., _____ ft.

Sand _____

Gas _____

Oil _____

Total Depth 5110

PRODUCTION

1st 24 hrs. Nat. _____

1st 24 hrs. after shot _____

Gas _____ Cu. Ft.

Dry Hole _____

Abandoned _____

Date

JUL 14 1943 19

S. J. LEWIS

Scout

KANSAS

Barber

Map No. 93 Sec. 22 Twp. 32 R. 15W

Well No. 1 Hilderbrand "B"

Champlin Oil Company

FIRST REPORT Contractor

SE NE SE


SECTION PLAT

990 Ft. from N. Line

_____ Ft. from S. Line

330 Ft. from E. Line

_____ Ft. from W. Line

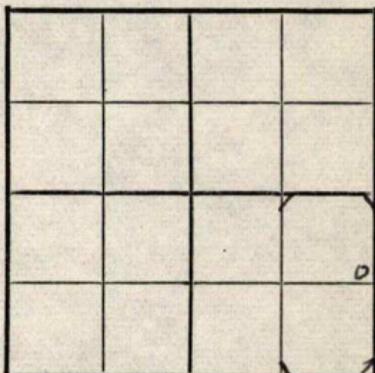

DEERHEAD POOL

Location _____

Rig up _____

Drilling and Remarks:

Derrick

RECORD

Cased _____ in., _____ ft.

Sand _____

Gas _____

Oil _____

Total Depth _____

PRODUCTION

1st 24 hrs. Nat. _____

1st 24 hrs. after shot _____

Gas _____ Cu. Ft.

Dry Hole _____

Abandoned _____

Date

MAY 1 9 1943

19

S. J. LEWIS

Scout