

KANSAS


Barber

FORM 51 5M PETROL

Section 22 Township 32 Range 15-W

Well No. #1 Mills

Company Champlin Oil & Ref.

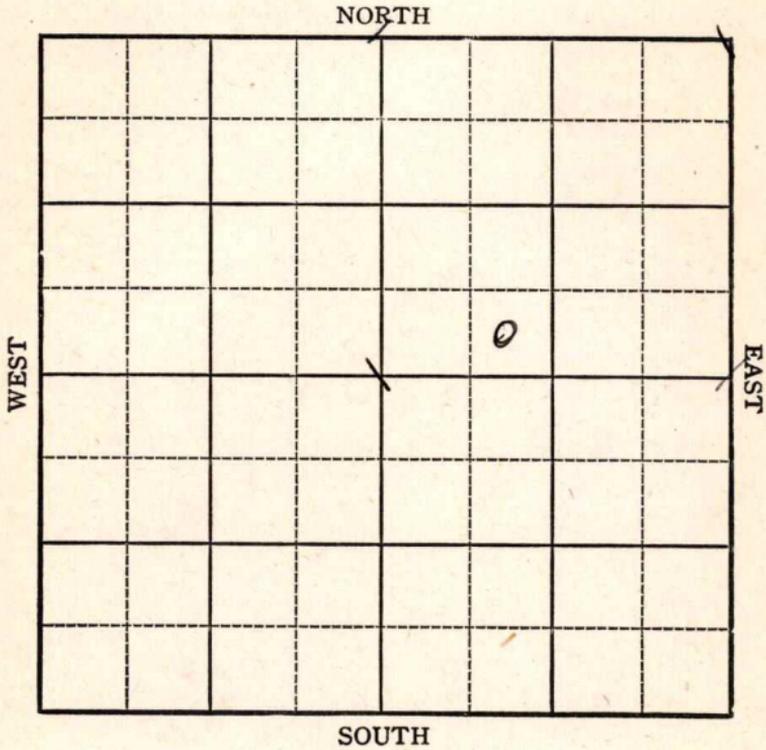

Sec. 22 Twp. 32 R. 15-W

Well No. #1 Mills Farm


Champlin Oil & Ref. Company

_____ Ft. from N. Line

330 Ft. from S. Line

_____ Ft. from E. Line

990 Ft. from W. Line

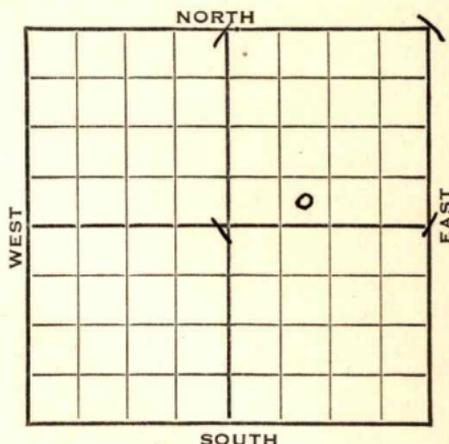

1943

REPORT

8/25 Derrick

9/1 10" @ 480

Drlg. 1460

9/8 Drlg. 2940'

9/15 Drlg. 4020'

9/22 Drlg. 4740'

9/29 **Viola 5011**
Drlg. 5040'

10/6 **Viola 5076 Corrected**

T.D. 5100'

5" @ 4964'

10/13 Plug 4800
10 shots 4780-90
VSSO & 3 BW

10/20 **Viola 5076**
5" @ 4964

Water

T.D. 5100'

ABANDONED

KANSAS

Map No. 73 Sec. 22 Twp. 32 R. 15W

Well No. 1 Mills

Champlin Oil & Ref. Company

ABANDONED Contractor

SE SW NE

SECTION PLAT

_____ Ft. from N. Line

330 Ft. from S. Line

_____ Ft. from E. Line

990 Ft. from W. Line

Deerhead Pool

Location _____

Rig up _____

Drilling and Remarks:

Viola 5076

5" @ 4964

Water.

RECORD

Cased _____ in., _____ ft.

Sand _____

Gas _____

Oil _____

Total Depth 5100

PRODUCTION

1st 24 hrs. Nat. _____

1st 24 hrs. after shot _____

Gas _____ Cu. Ft.

Dry Hole _____

Abandoned _____

Date

OCT 20 1943

19

S. J. LEWIS

Scout