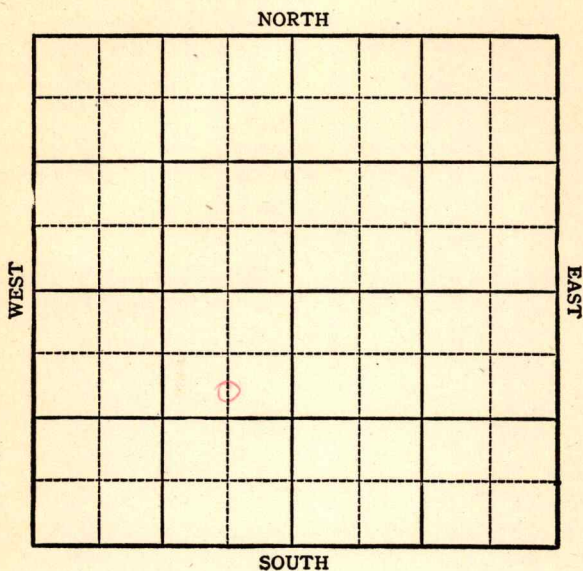


KANSAS

FORM 51 5M BRIX

Section 23 Township 32 Range 15WWell No. #7 HildebrandCompany Champlin Ref.

KANSAS

Sec. 23 Twp. 32 R. 15W

Well No. #7 Hildebrand Farm

Champlin Ref. Company


Hildebrand

990 Ft. from N. Line

Ft. from S. Line

660 Ft. from E. Line

Ft. from W. Line

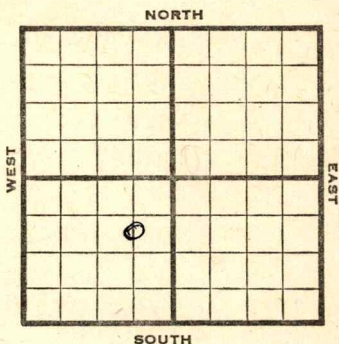

Barber C SL NE SW

1944 *Elev. 1964* R E P O R T

11/29 Loc.

12/6 Derrick

12/14 "

12/21 "

12/29 10" @ 480' Drlg. 2210'

1945

1/3 Drlg 3485

1/10 Drlg 4738

1/17 **Lans** 4225

Crg Viola 4966

TD 4983 gas run 5"

1/26 5" @ 4962'

1/31 " " "

2/7 RUST

2/14 "

2/21 **Viola** 4966

5" @ 4962

500 acid

TD 4987

10 M Gas.

COMPLETED

Pool Name HildebrandMap No. 93 Sec. 23 Twp. 32 R. 15WWell No. 7 HildebrandChamplin Ref. CompanyFIRST REPORT ContractorC SL NE SW

SECTION PLAT

990 Ft. from N. Line Ft. from S. Line660 Ft. from E. Line Ft. from W. LineBarberLocation XRig up

Drilling and Remarks:

RECORD

Cased in., ft.Sand Gas Oil Total Depth

PRODUCTION

1st 24 hrs. Nat. 1st 24 hrs. after shot Gas Cu. Ft.Dry Hole Abandoned

Date

NOV 29 1944

19

S. J. LEWIS

Scout

Pool Name HildebrandMap No. 93 Sec. 23 Twp. 32 R. 15WWell No. 7 HildebrandChamplin Ref. CompanyCOMPLETED


Contractor

C S L NE SW

SECTION PLAT

990 Ft. from N. Line Ft. from S. Line660 Ft. from E. Line Ft. from W. Line

Barber

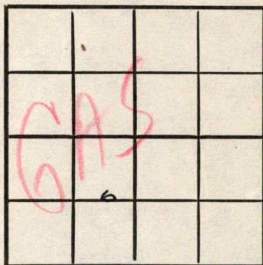Location Rig up

Drilling and Remarks:

Viola 4966
5" @ 4962
500 ac oil
10 M Gas

RECORD

Cased in., ft.Sand Gas Oil Total Depth 4987

PRODUCTION

1st 24 hrs. Nat. 1st 24 hrs. after shot Gas Cu. Ft.Dry Hole Abandoned

Date

FEB 21 1945

19

S. J. LEWIS

Scout