


Section 26 Township 32 Range 15W

Well No. #4, Hildebrand

Company Champlin Refg.

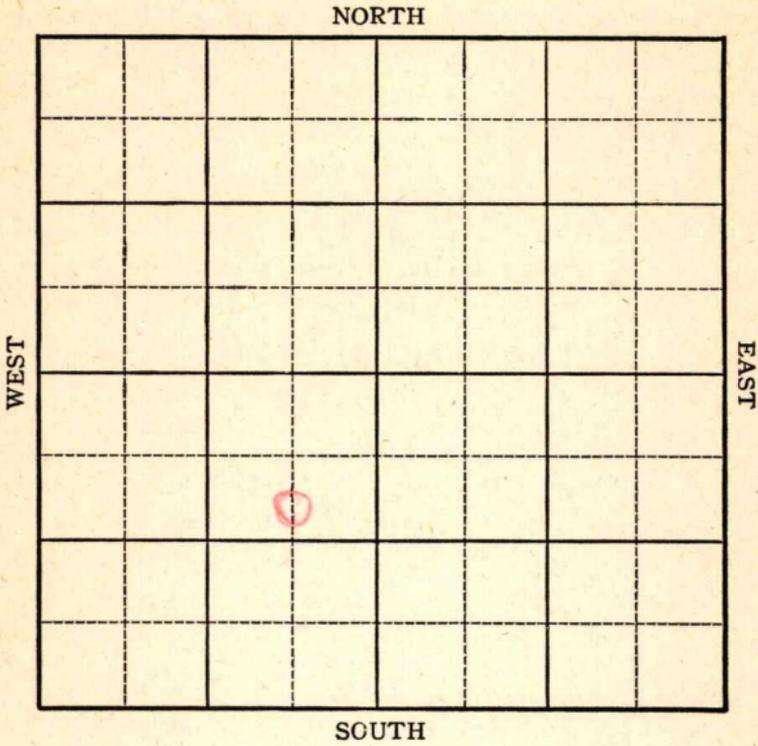

**KANSAS**

Barber County ✓

Sec. 26 Twp. 32 R. 15W

Well No. #4 Hildebrand Farm \_\_\_\_\_

Champlin Ref. \_\_\_\_\_ Company \_\_\_\_\_

Skinner


\_\_\_\_\_ Ft. from N. Line

1650 Ft. from S. Line

\_\_\_\_\_ Ft. from E. Line

1980 Ft. from W. Line

CSL NE SW

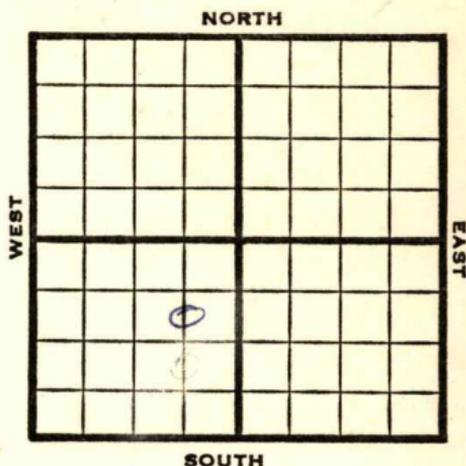

1946 **Elev 1980'** REPORT

4/3 10" @ 480' WOC

4/10 Drlg 2615

4/16 Drlg 3536

4/23 Drlg 4180'

5/1 Drlg 4673'

5/7 5033 TD  
Run 5"

5/14 **Lans 4236**  
**Magnoketa 5002**  
TD 5033  
5" @ 5033 RUST

5/21 TD 5037  
58 shots 5017-37,  
1000 acid, 3 M Gas

5/29 **Magwoketa 5002**  
5" @ 5033'  
Perf 1000 acid  
6 M Gas  
TD 5037'

**COMPLETED**

93  
KANSAS  
23

Kansas Pool Name Skinner

Map No. 23 Sec. 26 Twp. 32 R. 15W

Well No. 4 Hildebrand

Champlin Ref. Company

FIRST REPORT Contractor

C S L N E S W

SECTION PLAT


         Ft. from N. Line

1650 Ft. from S. Line

         Ft. from E. Line

1980 Ft. from W. Line

Barber County

Location                                 

Rig up                                 

Drilling and Remarks:

10" @ 480 WOC

RECORD

Cased          in.,          ft.

Sand                                 

Gas                                 

Oil                                 

Total Depth                         

PRODUCTION

1st 24 hrs. Nat.                         

1st 24 hrs. after shot                         

Gas                                  Cu. Ft.

Dry Hole                                 

Abandoned                                 

Date

APR 3 1946 19

S. J. LEWIS Scout

93  
KANSAS

Kansas Pool Name Skinner Pool

Map No. \_\_\_\_\_ Sec. 26 Twp. 32 R. 15W

Well No. 4 Hildebrand

Champlin Ref. Company \_\_\_\_\_

**COMPLETED**

Contractor \_\_\_\_\_

C S L N E SW


*E 1/1980*  
SECTION PLAT

\_\_\_\_\_ Ft. from N. Line

1650 Ft. from S. Line

\_\_\_\_\_ Ft. from E. Line

1980 Ft. from W. Line

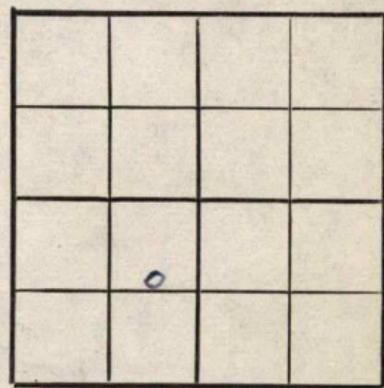

Barber County

Location \_\_\_\_\_

Rig up \_\_\_\_\_

Drilling and Remarks:

*Magnoketa 5002*  
*5" C 5033*  
*Perf. 1000 acid*  
*6M Gas*

**RECORD**

Cased \_\_\_\_\_ in., \_\_\_\_\_ ft.

Sand \_\_\_\_\_

Gas \_\_\_\_\_

Oil \_\_\_\_\_

Total Depth 5237

**PRODUCTION**

1st 24 hrs. Nat. \_\_\_\_\_

1st 24 hrs. after shot \_\_\_\_\_

Gas \_\_\_\_\_ Cu. Ft.

Dry Hole \_\_\_\_\_

Abandoned \_\_\_\_\_

Date

MAY 29 1946 19 \_\_\_\_\_

S. J. LEWIS

Scout