


Barber county

Section 26 Township 32 Range 15-W

Well No. #10, Hildebrand

Company Champlin Refg. Company

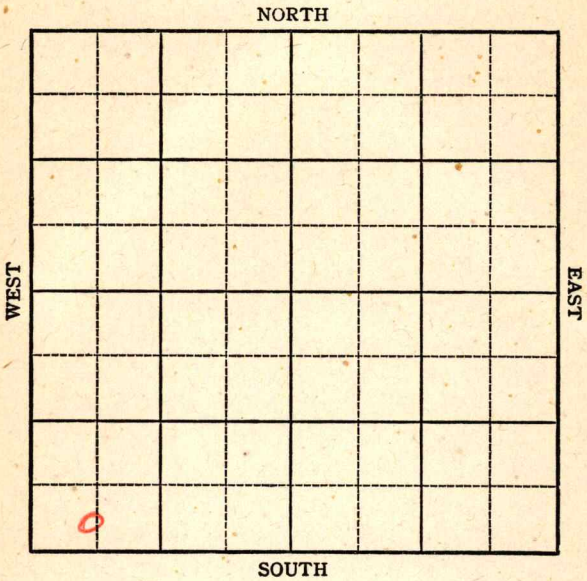

Sec. 26 Twp. 32 R. 15-W


Well No. #10, Hildenbrand Farm
Champlin Refg. Company Company
Deerhead

_____ Ft. from N. Line

330' Ft. from S. Line

_____ Ft. from E. Line

660' Ft. from W. Line

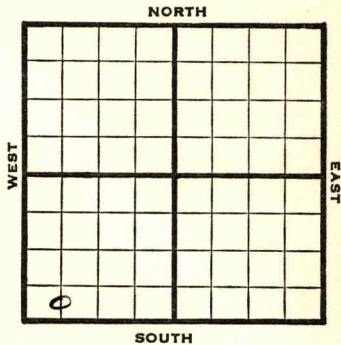

C S L SW SW

1946		REPORT
	Elev. 1930	
12/18	Derrick	
12/		
1947		
1/2	9" @ 521' Drlg 2843'	
1/8	Drlg 4130'	
1/15	Drlg 4835'	
1/21	Wap 4165 TD 4183' 5" @ 4183 RUST	
2/12	Wapanucka 4165 5" @ 4183 Perf 300 Acid Bomb Pot 2911 oil & 2% W Grav. 39 TD 4183'	

COMPLETED

Map No. _____ Sec. 26 Twp. 32 R. 15W

Well No. 10 Hildebrand

_____ Champlin Ref. _____ Company

FIRST REPORT

_____ Contractor

C S L SW SW

SECTION PLAT

_____ Ft. from N. Line

330 Ft. from S. Line

_____ Ft. from E. Line

660 Ft. from W. Line

Barber County

Location _____

Rig up _____

Drilling and Remarks:

Derrick

RECORD

Cased _____ in., _____ ft.

Sand _____

Gas _____

Oil _____

Total Depth _____

PRODUCTION

1st 24 hrs. Nat. _____

1st 24 hrs. after shot _____

Gas _____ Cu. Ft.

Dry Hole _____

Abandoned _____

Date

DEC 1 8 1946

19

S. J. LEWIS

Scout

Kansas

Map No. 93 Sec. 26 Twp. 32 R. 15W

Well No. 10 Hildebrand

Champlin Ref. Company

COMPLETE Contractor

C S L SW SW

E 1 1880

SECTION PLAT

Ft. from N. Line

330

Ft. from S. Line

Ft. from E. Line

660

Ft. from W. Line

Barber County

Location _____

Rig up _____

Drilling and Remarks:

Magnum peta 4165
5 1/2" @ 4163
Prof.
300 acid
Don't put 2911 oil
+ 2% W
3934

RECORD

Cased _____ in., _____ ft.

Sand _____

Gas _____

Oil _____

Total Depth 4180

PRODUCTION

1st 24 hrs. Nat. _____

1st 24 hrs. after shot _____

Gas _____ Cu. Ft.

Dry Hole _____

Abandoned _____

Date

FEB 1 2 1947

19

S. J. LEWIS

Scout