


Section 27 Township 32 Range 15W

Well No. 4 Baird

Company Champlin

Deerhead Pool

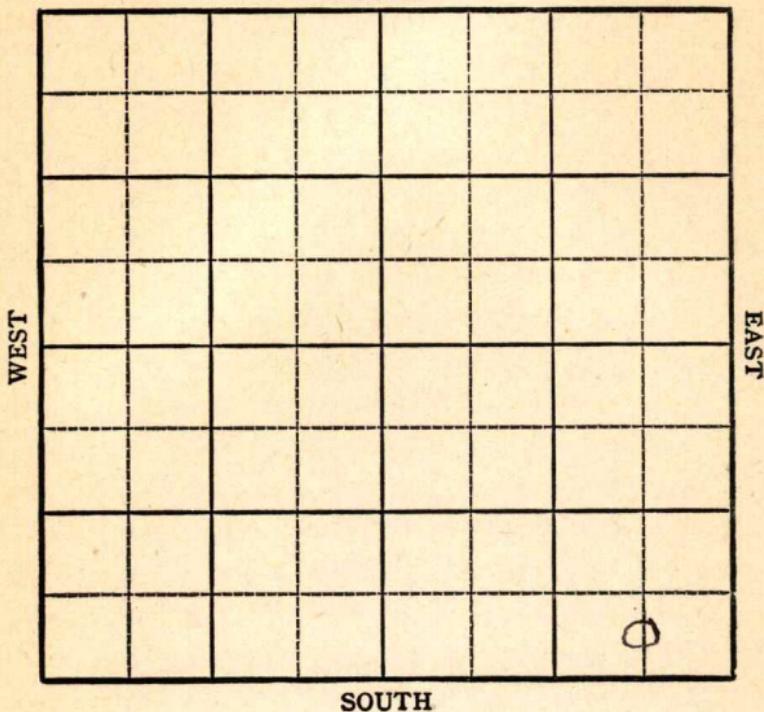

KANSAS

Barber



Sec. 27 Twp. 32 R. 15W

Well No. #4 Baird Farm _____

Champlin Company
Deerhead Pool


_____ Ft. from N. Line

330' Ft. from S. Line

660' Ft. from E. Line

_____ Ft. from W. Line

C S L S E S E

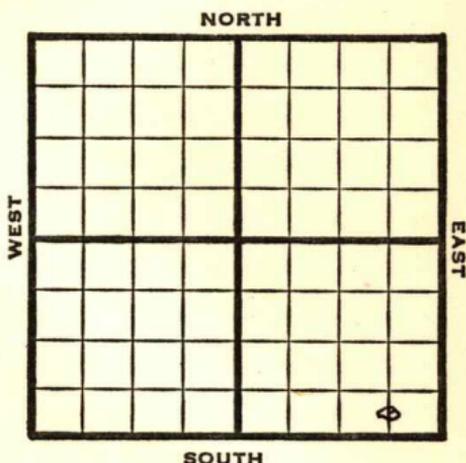

1948

Eli 1884'

REPORT

8/15

8" @ 795'
Drlg. 2650'

9/21

Drlg. 4185'

9/29

Viola 4926'
TD 4946'
Ran 5"

10/6

5" @ 4946'
30 shots 4929-34 200 acid
Flow 15 bbls oil & 15% W PH - 12 hrs.

10/13

"

10/20

TD 4946'
Viola 4926'
5" @ 4946'
Perf 2000 acid
Pump 328 Oil / 10% W Pot
41° Gr.
Comp

COMPLETED

Map No. 93 Sec. 27 Twp. 32 R. 15W

Well No. 4 Baird

Champlin Ref. Company

COMPLETE

Contractor

C S L SE SE

E 11/18/44
SECTION PLAT

_____ Ft. from N. Line

330 Ft. from S. Line

660 Ft. from E. Line

_____ Ft. from W. Line

Barber County

RECORD

Location _____

Cased _____ in., _____ ft.

Rig up _____

Sand _____

Drilling and Remarks:

Gas _____

Oil _____

Total Depth 4946

Vista 4926

5' @ 4946

*Perf.
200 acid*

Prod 325 oil + 10% W

Pat 41° SW

PRODUCTION

1st 24 hrs. Nat. _____

1st 24 hrs. after shot _____

Gas _____ Cu. Ft.

Dry Hole _____

Abandoned _____

Date

OCT 20 1948 19

S. J. LEWIS Scout