


KANSAS

Barber county

Section 27 Township 32 Range 15-W

Well No. #9, Hildebrand

Company Champlin Refg. Company

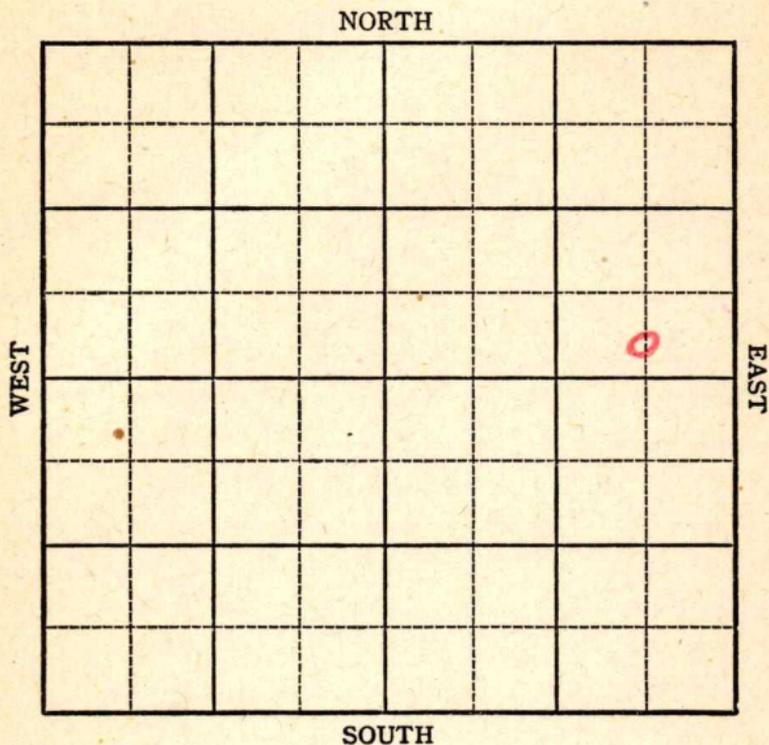

KANSAS

Barber county ✓

Sec. 27 Twp. 32 R. 15-W

Well No. #9, Hildebrand Farm

Champlin Refg. Company Company


Deerhead Pool

2116' Ft. from N. Line

_____ Ft. from S. Line

705' Ft. from E. Line

_____ Ft. from W. Line

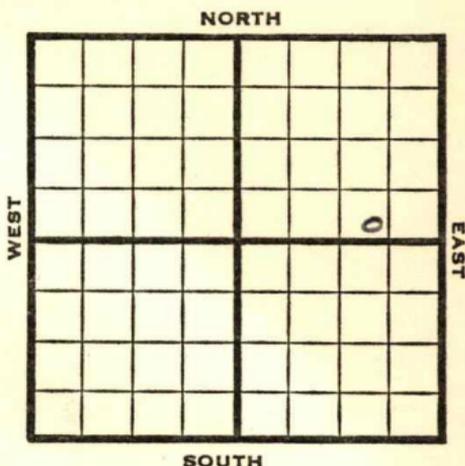

C S L SE NE

1946 **Elev. 1848'.** REPORT

- 12/11 Surface hole.
- 12/17 10" @ 500'
Drlg 2450'
- 1947
- 1/2 Drlg 4150'
- 1/8 Drlg 4595'
- 1/15 DD 4903'
5" @ 4902
RUST
- 1/21 Wap 4181
- 1/30 Wap 4181
48 shots 4885-97
500 Acid
- 2/5 Flow 100 fluid 1 hr
30% W
3 M Gas
- 2/12 " "
- 2/19 " "
- 2/26 " "

OVER

3/4 TD 4903'

3/11 " "

3/18 SD

3/25 "

4/2 Maquokete 4187'
5" @ 4902'
Perf. 500 Acid
Pump 251 Pot
40.0 Gr.
TD 4903'.

COMPLETED

Map No. K93 Sec. 27 Twp. 32 R. 15W

Well No. 9 Hildebrand

Champlin Ref. Company

COMPLETE

Contractor

C S L SE NE

ELIOTT
SECTION PLAT

2116 Ft. from N. Line

 Ft. from S. Line

705 Ft. from E. Line

 Ft. from W. Line

			0

Barber County

Location

Rig up

Drilling and Remarks:

Maguire #187
5704902
Ref. 5000000
Pump 251 Rod
40 = 1/2"

RECORD

Cased in., ft.

Sand

Gas

Oil

Total Depth 4902

PRODUCTION

1st 24 hrs. Nat.

1st 24 hrs. after shot

Gas Cu. Ft.

Dry Hole

Abandoned

Date

APR 2 1947 19

S. J. LEWIS Scout

