

KANSAS


Barber

FORM 51 5M BRIX

Section 26 Township 32 Range 15W

Well No. #5, Hildebrand

Company Champlin Ref.

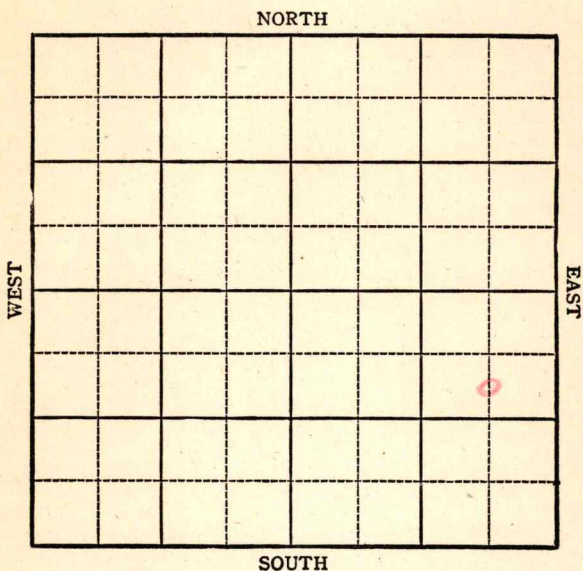


KANSAS

Sec. 26 Twp. 32 R. 15W

Well No. #5, Hildebrand Farm
Champlin Ref. Company

NORTH

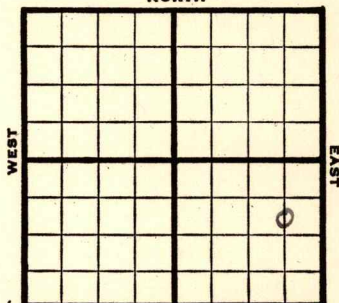

990 Ft. from N. Line

 Ft. from S. Line

660 Ft. from E. Line

 Ft. from W. Line

lev. 1984

SOUTH

1944

REPORT

6/7	Rotary
6/15	10" @ 480 Drlg. 2226
6/21	Drlg. 3200
6/28	Drlg 4700
7/12	Lans 4230 Miss 4760 Kind 4790 Simp 5125 TD 5145

ABANDONED

KANSAS

FORM 26 200 BKS. 2-44 PETROL

Pool Name Hildebrand

Map No. 93 Sec. 26 Twp. 32 R. 15W

Well No. 5 Hildebrand

Champlin Ref. Company

FIRST REPORT

Contractor

C S L N E S E

SECTION PLAT

990 Ft. from N. Line

Ft. from S. Line

660 Ft. from E. Line

Ft. from W. Line

			4

Barber County

Location

Rig up

Drilling and Remarks:

Rotary

RECORD

Cased in, ft.

Sand

Gas

Oil

Total Depth

PRODUCTION

1st 24 hrs. Nat.

1st 24 hrs. after shot

Gas Cu. Ft.

Dry Hole

Abandoned

Date

JUN 7 1944 19

S. J. LEWIS Scout

Pool Name HildebrandMap No. 93 Sec. 26 Twp. 32 R. 15WWell No. 5 Hildebrand

Champlin Ref.

Company

ABANDONED

Contractor

C S L N E S E

SECTION PLAT

990 Ft. from N. Line Ft. from S. Line660 Ft. from E. Line Ft. from W. LineBarber CountyLocation Rig up

Drilling and Remarks:

*Log 4230**Miss 4760**Kind 4790**Drup 5125*

RECORD

Cased in ft.Sand Gas Oil Total Depth 5145

PRODUCTION

1st 24 hrs. Nat. 1st 24 hrs. after shot Gas Cu. Ft.Dry Hole Abandoned

Date

JUL 12 1944 19S. J. LEWIS

Scout