

Section 26 Township 32 Range 15W


Well No. #12 Hilderbrand

Company Champlin Ref.
Deerhead Pool

NORTH

WEST

EAST

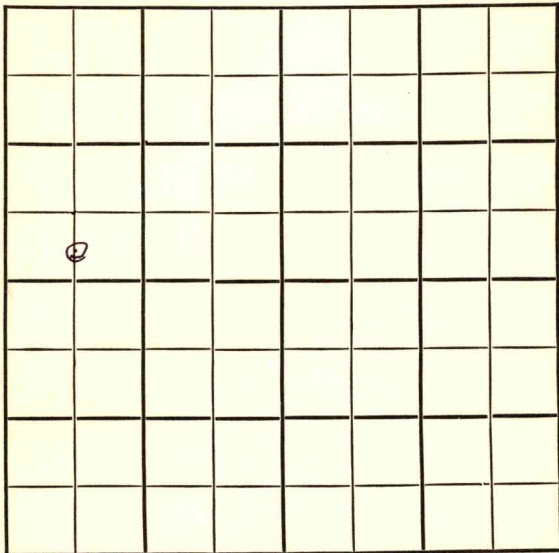

SOUTH

Sec. 26 Twp. 32 R. 15W

Well No. #12 Hilderbrand Farm

Champlin Ref.

Company

Deerhead


 Ft. from N. Line

330 Ft. from S. Line

 Ft. from E. Line

660 Ft. from W. Line

C S L SW NW

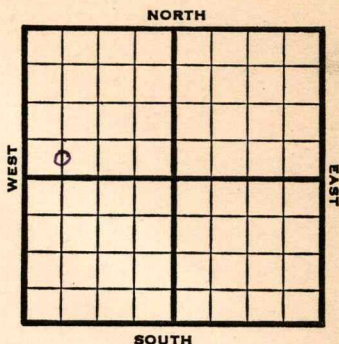

1948

Elev. 1924'

REPORT

4/14

Location

4/21

10" @ 465'

8" @ 800'

Lansing 4240'

Viola 4945'

Drlg. 4963'

4/28

TD 5002'

5" @ 5002'

35 shots 4987-88' 2000 acid.

Flow 15 bbls. oil PH 3 M gas / 16% W.

5/5

"

5/12

"

5/19

"

5/26

"

6/1

"

6/9

"

6/16

"

6/23

"

6/29

"

7/8

"

"

7/14

"

"

7/21

"

"

7/28

"

"

8/4

"

OVER

1948

8/11

Viola 4945'

5" @ 5002'

TD 5002'

Perf.

ABANDONED

Map No. _____ Sec. 26 Twp. 32 R. 15W

Well No. 12 Hilderbrand

_____ Champlin Ref. _____ Company

FIRST REPORT

_____ Contractor

C S L SW NW

SECTION PLAT

_____ Ft. from N. Line

330 Ft. from S. Line

_____ Ft. from E. Line

660 Ft. from W. Line

Barber County

Location X

Rig up _____

Drilling and Remarks:

RECORD

Cased _____ in., _____ ft.

Sand _____

Gas _____

Oil _____

Total Depth _____

PRODUCTION

1st 24 hrs. Nat. _____

1st 24 hrs. after shot _____

Gas _____ Cu. Ft.

Dry Hole _____

Abandoned _____

Date

APR 14 1948

19

S. J. LEWIS

Scout

Barber County Kansas State

Map No. 93 Sec. 26 Twp. 32 R. 15W

Well No. 12 Hilderbrand

Champlin Ref. Company

ABANDONED Contractor

C S L SW NW


E1, 1924
SECTION PLAT

 Ft. from N. Line

330 Ft. from S. Line

 Ft. from E. Line

660 Ft. from W. Line

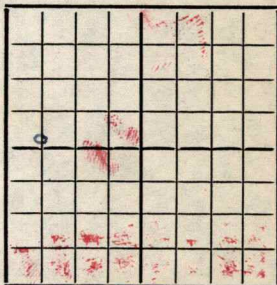

Deerhead Pool

Remarks:

Viola 4945

5" C0002

MD5002

Prof.

Date

AUG 11 1948

Scout S. J. LEWIS