KANSAS


FORM 51 5M 6-46 PETROL

Barber County

Section 27 Township 32 Range 15W

Well No. #2 Baird

Company Champlin Ref.

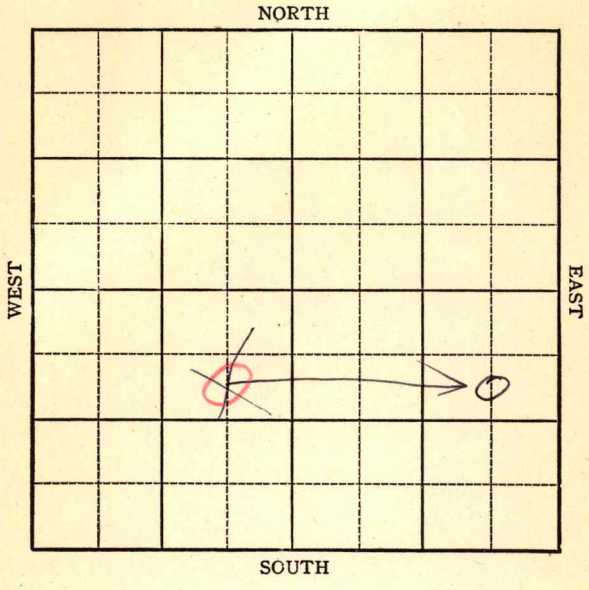

FORM 252-A
5M 6-46 PETROL

KANSAS

Barber County ✓

Sec. 27 Twp. 32 R. 15W

Well No. #2 Baird Farm

Champlin Ref. Company

Deerhead


990 Ft. from N. Line

Ft. from S. Line

660 Ft. from E. Line

Ft. from W. Line

CSL NE ~~SW~~ SE

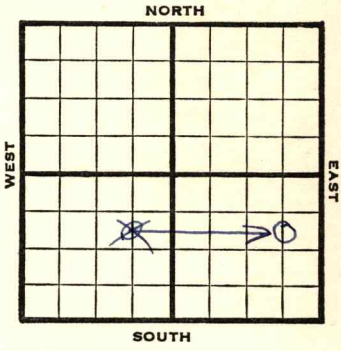

1946	1908 REPORT
7/10	10" @ 480 Drlg. 500'
7/16	Drlg 2865'
7/23	Drlg 4122'
7/30	Drlg 4790'
8/6	Viola 4958' Drlg 5078'
8/13	Arb 5242 TD 5280' Run 5"
8/20	5" @ 5025' 24 shots 4952-56 500 acid, pump 25 oil a day
8/27	" " "
9/5	" " "
9/10	Flow 35 oil in 4 hrs
9/18	" " "
9/24	" " "
10/2	Miss 4754' Arb 5242' 5" @ 5025' TD 5280' Perf Miss 500 acid Bomb & Pot 19,000 3000 Max Grav 39 COMPLETED

FORM 26 200 BKS 2-44 PETROL

KANSAS Kansas Pool Name Deerhead

Map No. 23 Sec. 27 Twp. 32 R. 15W


Well No. 2 Baird

Champlin Ref. Company

FIRST REPORT Contractor

C S L NE SW

SECTION PLAT

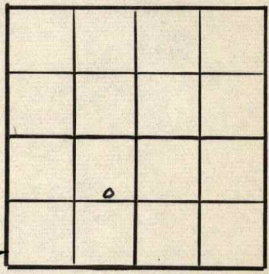

990 Ft. from N. Line

Ft. from S. Line

660 Ft. from E. Line

Ft. from W. Line

Barber County

Location

Rig up

Drilling and Remarks:

10" @ 480'

500'

RECORD

Cased in., ft.

Sand

Gas

Oil

Total Depth

PRODUCTION

1st 24 hrs. Nat.

1st 24 hrs. after shot

Gas Cu. Ft.

Dry Hole

Abandoned

Date

JUL 10 1946 19 S. J. LEWIS Scout

FORM 56 200 BKS. 1-44 PETROL

Kansas Pool Name Deerhead

Map No. 93 Sec. 27 Twp. 32 R. 15W

Well No. 2 Baird

Champlin Ref. Company

CORRECTION Contractor

C S L NE SE


990 Ft. from N. Line

Ft. from S. Line

660 Ft. from E. Line

Ft. from W. Line

SECTION PLAT

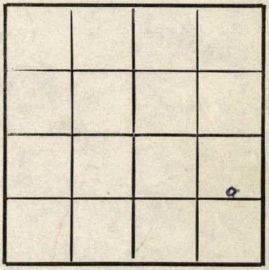

Barber County

Location

Rig up

Drilling and Remarks:

Reported

C S L NE SW

RECORD

Cased in., ft.

Sand

Gas

Oil

Total Depth

PRODUCTION

1st 24 hrs. Nat.

1st 24 hrs. after shot

Gas Cu. Ft.

Dry Hole

Abandoned

Date

JUL 2 4 1946 19

S. J. LEWIS Scout

FORM 26 200 BKS 2-44 PETROL

KANSAS

Kansas Pool Name Deerhead Pool

Map No. 93 Sec. 27 Twp. 32 R. 15W

Well No. 2 Baird


Champlin Ref. Company

COMPLETED Contractor

C S L NE SE

El. 1908

SECTION PLAT

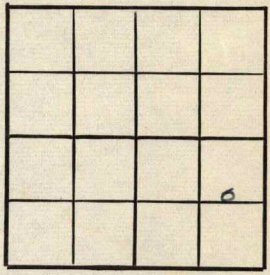

990 Ft. from N. Line

Ft. from S. Line

660 Ft. from E. Line

Ft. from W. Line

Barber County

Location

Rig up

Drilling and Remarks:

Miss 4754
Ar 5242
5½ @ 5285
Rig/Miss 5 days
Bomb/Ar 19,000
Good Mud

RECORD

Cased in., ft.

Sand

Gas

Oil

Total Depth 5288

PRODUCTION

1st 24 hrs. Nat.

1st 24 hrs. after shot

Gas Cu. Ft.

Dry Hole

Abandoned

39-2W

Date

OCT 2 1946 19 S. J. LEWIS Scout