

STATE CORPORATION COMMISSION OF KANSAS OIL & GAS CONSERVATION DIVISION

WELL COMPLETION OR RECOMPLETION FORM ACO-1 WELL HISTORY

DESCRIPTION OF WELL AND LEASE

Operator: license # 5447
name Cities Service Oil & Gas Corp.
address 3545 NW 58th Street
City/State/Zip Oklahoma City, OK 73112

Operator Contact Person Raymond Hui
Phone (405) 949-4400

Drill Contractor: license # 5302
name Red Tiger Drilling Company

Wellsite Geologist
Phone

Designate Type of Completion

☒ New Well ☐ Re-Entry

☐ Oil ☐ SWD ☐ Temp Abd
☐ Gas ☐ Inj ☐ Delayed Completion
☒ Dry ☐ Other (Core, Water Supply etc.)

OWWO: old well info as follows:

Operator
Well Name
Comp. Date Old Total Depth

WELL HISTORY

Drilling Method: ☒ Mud Rotary ☐ Air Rotary ☐ Cable
3-14-85
4-7-85 4-7-85
Spud Date Date Reached TD Completion Date

5850'
Total Depth PBTD

Amount of Surface Pipe Set and Cemented at 88' KB feet

Multiple Stage Cementing Collar Used? ☐ Yes ☒ No

If Yes, Show Depth Set feet

If alternate 2 completion, cement circulated
from feet depth to w/ SX cmt

API NO. 15 033-20674

County Comanche

SW SW Sec. 26 Twp. 32S. Rge. 18

660 Ft North from Southeast Corner of Sec

4470 Ft West from Southeast Corner of Sec

(Note: locate well in section plat below)


Lease Name Dale "A" Well# 2

Field Name Nescatunga

Producing Formation Dry Hole

Elevation: Ground 2025' KB 2032'

Section Plat

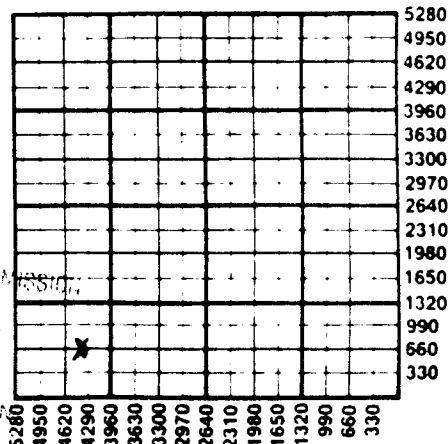

APR 22 1985
State Geological Survey
WICHITA BRANCH
RECEIVED
APR 24 1985
KANSAS CORPORATION COMMISSION
Wichita, Kansas

WATER SUPPLY INFORMATION

Source of Water:

Division of Water Resources Permit # T 85-301

☒ Groundwater 810 Ft North From Southeast Corn
(Well) 4470 Ft West From Southeast Co
Sec 26 Twp 32S Rge 18 ☐ East ☒ West

☐ Surface Water Ft North From Southeast Corn
(Stream, Pond etc.) Ft West From Southeast
Sec Twp Rge ☐ East ☐ West

☐ Other (explain)
(purchased from city, R.W.D. #)

Disposition of Produced Water: ☐ Disposal ☐ Repressuring

Docket #

INSTRUCTIONS: This form shall be completed in duplicate and filed with the Kansas Corporation Commission, 200 Colorado Derby Building, Wichita, Kansas 67202, within 90 days after completion or recompletion of any well. Rules 82-3-130 and 82-3-107 apply.

Information on side two of this form will be held confidential for a period of 12 months if requested in writing and submitted with the form. See rule 82-3-107 for confidentiality in excess of 12 months.

One copy of all wireline logs and drillers time log shall be attached with this form. Submit CP-4 form with all plugged wells. Submit CP-111 form for all temporarily abandoned wells.

Operator Name Cities Service Oil & Gas Corp. Lease Name Dale "A" Well # 2 SEC 26 TWP 32S RGE 18 XX

WELL LOG

INSTRUCTIONS: Show important tops and base of formations penetrated. Detail all cores. Report all drill stem testing interval tested, time tool open and closed, flowing and shut-in pressures, whether shut-in pressure reached level, hydrostatic pressures, bottom hole temperature, fluid recovery, and flow rates if gas to surface during test. Attach extra sheet if more space is needed. Attach copy of log.

Drill Stem Tests Taken ☒ Yes ☐ No
Samples Sent to Geological Survey ☐ Yes ☐ No
Cores Taken ☐ Yes ☐ No

Formation Description
☒ Log ☐ Sample

DST #1 5102' to 5160'
58' Miss.
30-60-30-60

Name Top Bottom

Mississippi 5120
Viola 5610

DST #2 5601' to 5625'
24' Viola
30-60-60-120

TD 5850'

Ran GR-N Logs.

APR 23 1985

State Geological Survey
WICHITA BRANCH

CASING RECORD

☒ new ☐ used

Report all strings set - conductor, surface, intermediate, production, etc.

Purpose of string	size hole drilled	size casing set (in O.D.)	weight lbs/ft.	setting depth	type of cement	# sacks used	type and percent additives
Surface	17-1/4"	13-3/8"	48#	88' KB	Class A	90	2% CaCl-2 +
Intermediate	12-1/4"	8-5/8"	24#	570 RKB	Howco Lite	150	3% CaCl-2 +
					Class A	150	2% CaCl-2 + Gilsoni 1 sack floe

PERFORATION RECORD

Acid, Fracture, Shot, Cement Squeeze Record

shots per foot	specify footage of each interval perforated	(amount and kind of material used)	Depth
Not	Perforated - Dry Hole		