


Map No. **KANSAS** Sec. 2 Twp. 32 R. 2 W

Well No. 1 - Belsey Farm
Winkler & Koch et al Company

NORTH

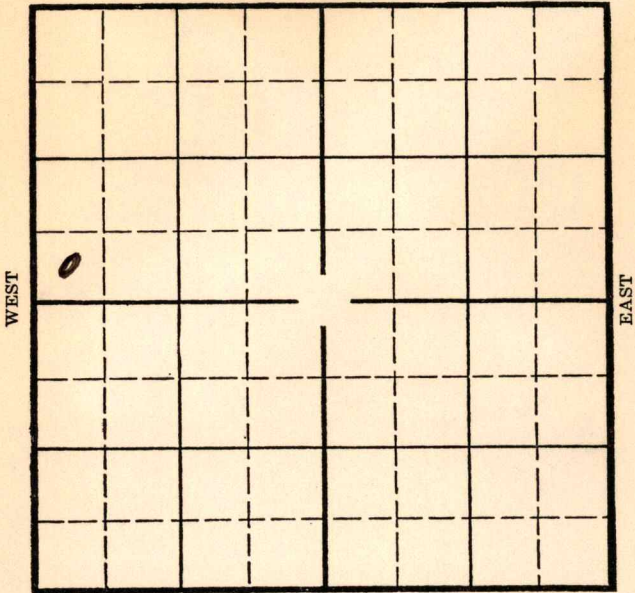

SOUTH

Location _____
Drilling Remarks _____

Rig Up _____
Drilling Remarks _____

RECORD

PRODUCTION

Cased _____ in. _____ ft.
 Sand _____
 Gas _____
 Oil _____
 Total Depth _____


1st 24 hrs. Nat. _____
 1st 24 hrs. after shot _____
 Gas _____ cu. ft. _____
 Dry Hole _____
 Abandoned _____

Summer

Map No. Sec. 2 Twp. 32 R. 2W

Well No. 1- Belsley Farm
Winkler & Koch etc Company

_____ Ft. from N. Line
330 Ft. from S. Line
_____ Ft. from E. Line
330 Ft. from W. Line

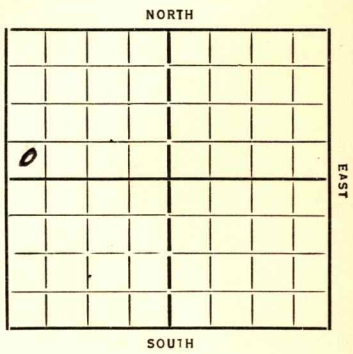

Elev. 1273

Date	REPORT	
6/19	Location	
6/28	Log	
7/3	Relg	
7/11	Alg 362	4261
7/18	10" 345	1273
8/8	Alg 2465	2988
8/15	2900	4359
8/22	8/29	1273
9/6	2900 @O.	3086
10/3	Alg 4199 TML 3844	
10/19	4201 lost circ	
11/1	Base line 4192	
	TY 4261 Alg 4266	
11/13	Alg 4359	
	TD 4408	

D.F.F.

ABANDONED

Map No. 31 Sec. 2 Twp. 32 R. 2W

Well No. 1-Belsley

Winkler + Koch et al Company

Contractor

FIRST REPORTS

SECTION PLAT

..... Ft. from N. Line

330 Ft. from S. Line

..... Ft. from E. Line

330 Ft. from W. Line

0			

Location

Rig up.....

Drilling and Remarks:

RECORD

Cased..... in., ft.

Sand.....

Gas.....

Oil.....

Total Depth.....

PRODUCTION

1st 24 hrs. Nat.....

1st 24 hrs. after shot.....

Gas..... Cu. Ft.

Dry Hole.....

Abandoned.....

Date

6-19-35 192.....

ORVAL MANNSCHRECK

Scout

Map No. 31 Sec. 2 Twp. 32 R. 2W

Well No. 1-Belsley

Winkler + Koch Company

Contractor

ABANDONED

SECTION PLAT

0			

Ft. from N. Line

330 Ft. from S. Line

Ft. from E. Line

330 Ft. from W. Line

Location

Rig up

Drilling and Remarks:

10+17 F

RECORD

Cased in., ft.

Sand sil 4359

Gas

Oil

Total Depth 4408

PRODUCTION

1st 24 hrs. Nat.

1st 24 hrs. after shot

Gas Cu. Ft.

Dry Hole

Abandoned

Date

11-13-35 192

ORVAL MANNSCHRECK

Scout