


Summer

SECTION 19 TOWNSHIP 32 S RANGE 2 W

WELL NO. # 3 W. C. Nunn

COMPANY So. Texas Develop.

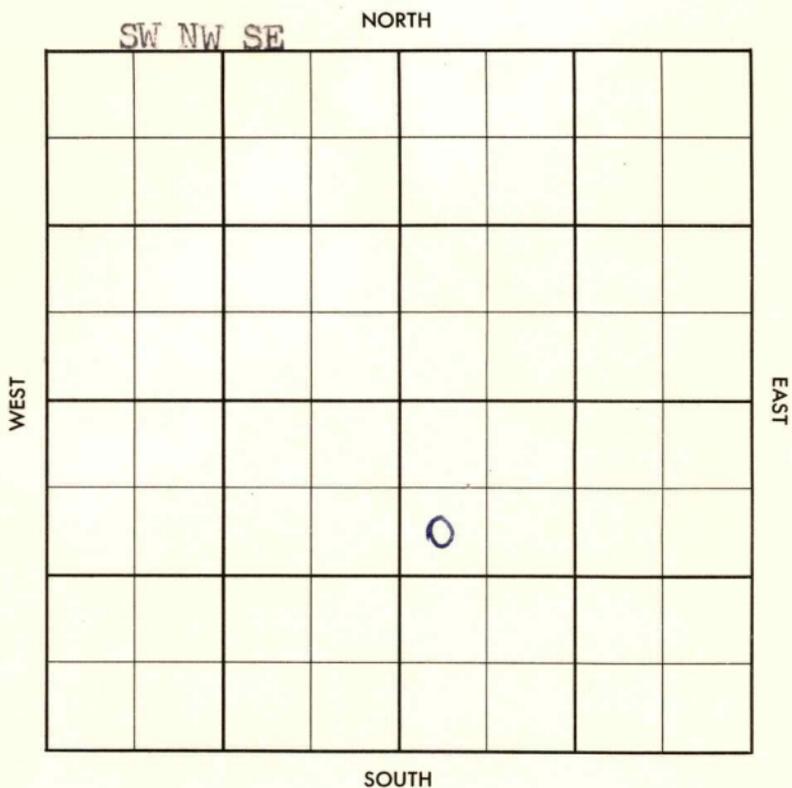

County Sumner Elev. _____
 Sec. 19 Twp. 32 Rgs. 2W
 Company So. Texas Develop.
 Farm Name W. G. Nunn No. 3

TOPS	DEPTH	LOG	DATUM	Loc. in Sec.
Anb.				SW NW SE
TP				
H. <u>Staln.</u>	<u>2920</u>			
Tr.				
Dg.				
BL.				
L.				
K.C.				Geol. _____
B.K.C.				Contr. <u>McKna</u>
Ce.				<u>Lindsay Tool</u>
C.				Pool _____
M.				<u>Mayfield</u>
M.				
K.				
Mz.				
Me.				
V.				
S.				
S.				
A.				
R.				
Pe.				
G.				
T.D.				

FIRST REPORT
 AUG 28 37

Date Comm. 8-22-57 Mag. - AC
8" @ 525/375, Drlg. 3037

~~19~~

Sec. T. R.

28

FORM 513 SUNRAY

County Sumner Elev. 1237 DF
 Sec. 19 Twp. 32 Rge. 2W
 Company So. Texas Develop.
 Farm Name W. C. Nunn No. 3

Co.

TOPS	DEPTH	LOG	DATUM
Anb.			
TP			
H. <u>Staln.</u>	<u>2920</u>		
Tr.			
Dg.			
BL.			
L.			
K.C.	<u>3210</u>		
B.K.C.			
Ce.			
C.			
M.	<u>3974</u>		
M.			
K.			
Mz.			
Mq.			
V.			
S. <u>sd</u>	<u>4275</u>		
S.	<u>1</u>		
A.			
R.			
PE.			
G.			
TD.	<u>4280</u>		

Loc. in Sec. SW NW SE

Geol. _____
Contr. McKnab & Lindsay Tools

Pool Mayfield

COMPLETE	
0	57
OCT	9

158

No.

Sec.

T.

R.

Date Comm. 8-22-57 Mag. - AC

8" @ 525/375, Dr. 3037 SEP 4 57

SEP 11 57 DST 4275-80 2 hrs

2016' oil 324 HOCM FP
50-565 BHP 158 5/30"

Log 5 1/2 4275 WOC CO
4280 Flw 102 BO no w

12 hrs 1" CHK Nat, Pipe 4273

SEP 25 57 FLO 117.86 BO no w 21 hrs

1 1/2" CHK OCT 2 57 WOPOT OCT 9 57

PHY 146 B0 + ~~146~~ 390W
42° 9N

open Hole 4275 - 80