


Section 1 Township 32 Range 20W

Well No. 1-A Ellis

Company Huber Corp.

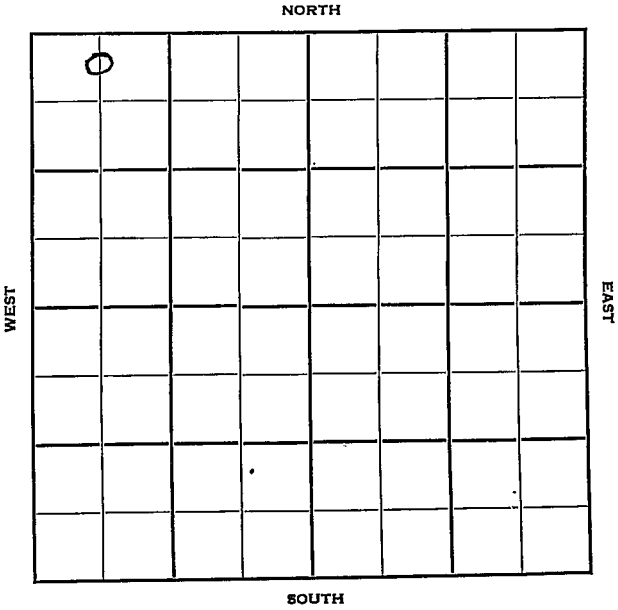

Sec. 1 Twp. 32 R. 20W

Well No. #1-A Ellis Farm

Huber Corp. Company

Rine Drlg. Contractor  
Wildcat


395 Ft. from N. Line

..... Ft. from S. Line

..... Ft. from E. Line

542 Ft. from W. Line

C N L NW NW (TWIN WELL)

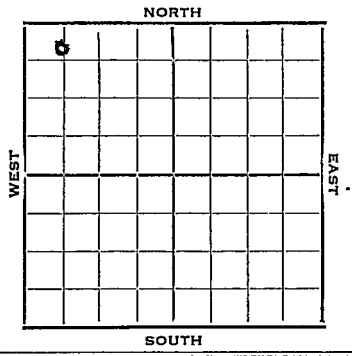

1952 Elev. 2027' REPORT

12/10 Spud 12-8-52  
18" @ 142  
Drlg. 145

12/11 ø145

12/18 ø2685

12/25 Drlg 2685

1953

1/7 Spud 12-8-52

D&A

TD 5240

18" @ 142

DST 4105-15, opn 1 hr., rec. 120'

SW Elgin sd. 4104, Heeb: 4246,

Doug 4320, ans 4450, Miss 5127,

DST 5150-5240, opn 1 hr., rec.

150' vsgcm, 1475#

TD 5240

D&A

**ABANDONED**

