

SEP 29 1972

KANSAS CORPORATION COMMISSION

WELL RECORD

API # 15-025-20,027


32-32-21 W

CW $\frac{1}{2}$ E $\frac{1}{2}$ SW

✓

(Mail to Kansas Geological Survey, 4150 Monroe Street, Wichita, Kansas 67209)

Clark County

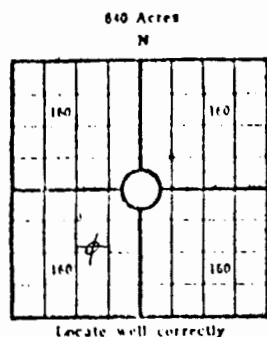

Lease Name: REDGER Well No. 1
Well Located: C W/2 E/2 SW/4
SEC 32 TWP 32S RGE 21W
Operator: Edmiston Oil Company
Address: 801 First National Bank Bldg.
Elevation: Ground 1933 D.F. 1935 K.B. 1938
Type Well: (Oil, gas, dry hole) dry hole

Drilling Commenced: July 24, 1972 Drilling Completed: August 13, 1972
Well Completed: Aug. 14, 1972 Total Depth 5305
Initial Production: _____

Casing Record

Size: 8-5/8" Set at 599' Size: _____ Set at _____
Size: _____ Set at _____ Size: _____ Set at _____

Liner Record

Size: _____ Set from _____ To _____

Cementing

Casing Size	Sacks	Type Cement and Additives
<u>8-5/8"</u>	<u>400</u>	<u>200 sx. 50-50 Pozmix; 200 sx. Sunset</u>
_____	_____	_____
_____	_____	_____

Perforations

Formation	Perforated Interval and Number Shots
_____	_____
_____	_____
_____	_____
_____	_____

Electric Log Run (Show type log and depths covered)

Electra Radiation Accurolog 4200 - 5305 T.D.

FORMATION, TESTING AND COMPLETION RECORD

Show Drill Stem Tests,
Well Stimulation and
Production Tests

Formation	Top	Bottom	
Shale	0	40	
Sand	40	90	
Gravel	90	187	
Dakota Sand	187	330	
Shale	330	600	
Shale w/Lime			
Streaks	600	1150	
Shale & Shells	1150	1900	
Shale & Lime	1900	4075	
Lime	4075	4168	
Lime & Shale	4168	4486	
Lime	4648	5305	
		RTD	
			D.S.T. #1, 5225-40'. Misrun.
			D.S.T. #2, 5215-40'. Open 1 hr. Rec. 180'
			mud. ISIP 53#/60 min., FSIP 23#/60 min.,
			FP 0#.
			D.S.T. #3, 5215-60'. Open 1 hr. Rec. 15'
			mud. All pressures 0#.

