


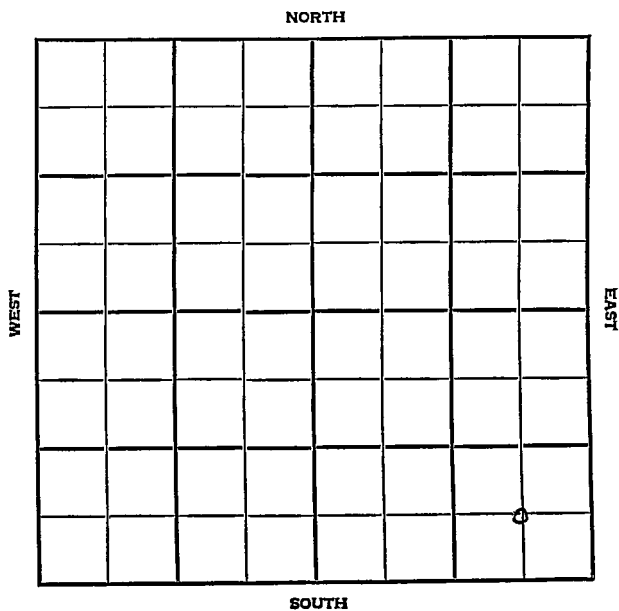

Clark		
SEC.	TWP.	R. KANSAS
10	32	21W
WELL NO. #1 J.E. Stephens "H"		
FARM		
COMPANY Shamrock Oil		
CONTRACTOR		

Co. Tools
Wildcat.

Ft. from N. Line


660

Ft. from S. Line

660

Ft. from E. Line

Ft. from W. Line

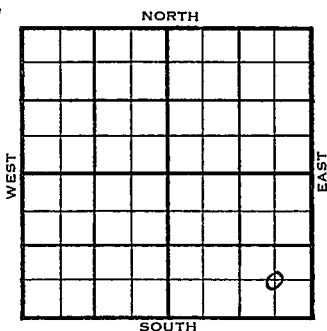

C SE SE

1954	ELEVATION	REPORT
	1985'	

10/20 M I R

MissTest.

1955
3/2

Spud 10-15-54 Gas well TD 5213
12 @ 558 Hol. 2347 Her. 2420
DST 3085-3130 open 27 min rec 20' mud
dy SW 1060#
DST 4643-66, op 1 hr rec 90' SW. 1710#
DST 4852-70 open 25 min rec 5' mud,
730#
DST 5189-97, gas in 1 min, 5,800,000
CFG 1 gal dist 1880#
DST 5197-5210 open 1/2 hr gas in 1 min
10,100,000 CFG, 60' oil, 270' SW
1800#. TD 5210 DD 5215 CO to 5214
20/5206-11 F/16.37 BO 9.62 BW
2,496,000 CFG 7 hr. F/32 BO
3,996,000 CFG 5-3/4 hr.
48/5193-5206 F/5.26 BO
4,680,000 CFG F/2.92 BO 1,625,000
CFG 2 1/2 hr. Comp. 14,000,000 CFGPD
3.82 bbl dist. Schl tops:
Cim. 1000, Well. 1556, Hol. 2380',
Her. 2420', Kri. 2455', Penn 3282',
Missouri 4078', KC 4433, Marm, 4818',
Cherokee 5024', Morrow sh. 5180',
Morrow sd. 5193' TD 5213'


COMPLETED

County Clark State Kansas
 Sec. 10 (Blk. Twp.) 32 (Sur. Rge.) 21W Map No.

Operator Shamrock Oil

Well No. 1 Farm J. E. Stephens "H"

Elev. Location C SE SE

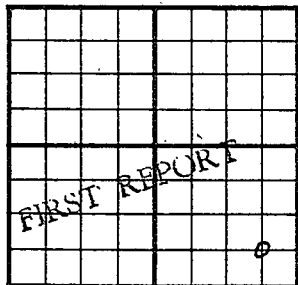

660 Ft. From S Line SE

660 Ft. From E Line Quarter

1st. Report OCT 20 1951

Completion

Remarks Miss. test

Co. tools


Spudding Date

Drig. Data Wildcat

M I R

FABEN GILSTRAP

County Clark State Kansas
 Sec. 10 (Blk. 32 (Sur. 21W Map No.)
 (Twp.) (Rge.)
 Operator Shamrock Oil
 Well No. 1 Farm J. E. Stephens "H"
 Elev. 1985 Location C SE SE

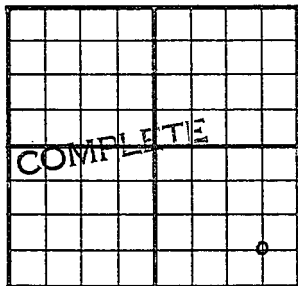660 Ft. From S Line SE660 Ft. From E Line Quarter

1st. Report

Completion MAR 9 1955Remarks Wildcat

Co. tools

Spudding Date 10-15-54Drlg. Data Gas well TD 521312" @ 558 Hol. 2347 Her. 2420DST 3085-3130 open 27 min. Rec. 20'muddy sw 1060# DST 4643-66' open 1 hr.Rec. 90' sw 1710# DST 4852-70 open25 min. Rec. 5' mud 730# DST 5189-97 gas in 1 min. 5,800,000 cfg1 gal. dist. 1880# DST 5197-5210open 1/2 hr. gas in 1 min. 10,100,000 cfg60' oil 270' sw 1800# TD 5210DD 5215 CO to 5214 20/ 5206-11F/ 16.37 bo 9.62 bw 2,496,000 cfg 7 hr.F/ 32 bo 3,996,000 cfg 5 3/4 hr.48/ 5193-5206 F/ 5.26 bo 4,680,000 cfgF/ 2.92 bo 1,625,000 cfg 2 1/2 hr.

FABEN GILSTRAND

Drlg. Data

Comp. 14,000,000 cfdpd 3.82 bbl. dist.

SCHLUMBERGER TOPS:

Cim. 1000 Well-1556 Hol. 2380

Her. 2420 Kri 2455 de Penna 3282

~~Missouri~~ Morrow 4078 KC 4433 Marm. 4818

Cherokee 5024 Morrow sh. 5180

Morrow 5193 TD 5213